

CODED

MISSISSIPPI
 BOARD OF WATER COMMISSIONERS
 416 North State Street
 Jackson, Mississippi 39201

CODED

CODED

WATER WELL DRILLERS LOG

PAZOO
 K 41
 8-15-68

Aug. 15 1968 J. H. Raines season
 date well completed firm name county well located

LANDOWNER: WALLACE F. TAYLOR
 VAZOO CITY, MISS
 RT. 1
 (mailing address)

WELL LOCATION:
 sec. 36 T. 11 N. R. 3 E.
 2 miles South of CRUPP
 (distance) (direction) (nearest town)


WELL PURPOSE: HOME
 (home, irrigation, municipal, industrial)

WELL COMPLETION DATA:

- (1) diameter (inches) 4"
- (2) total depth (feet) 1118
- (3) static water level (feet) 210 below top of ground.
- (4) casing PIPE 1098 (material) (depth)
- (5) screen 20 1098 (length) (depth to top)
 2" Stainless Steel (size) (material)
- (6) pump 1 10 (HP) (yield gpm)
 Elect. (type power)
- (7) electric log No (yes or no)
- (8) how well bottom plugged Backs
 2nd & 3rd

description of formations encountered	from	to
Top Soil	0	35
Sand & Gravel	110	75
Clay	305	380
Weathered Sand	10	240
Shell	15	405
Sand	80	485
Sand & Shell	102	587
Sand	35	622
Brack. thin layer	30	657
Dark Brackish		
Shell	80	732
Sandy Shell	110	772
Brackish	1	773
Dark Shell	85	854
Sandy Shell	105	913
Tap off Spout		
Shell	10	973
Shell	35	1008
Sand Head	110	1118

CODED

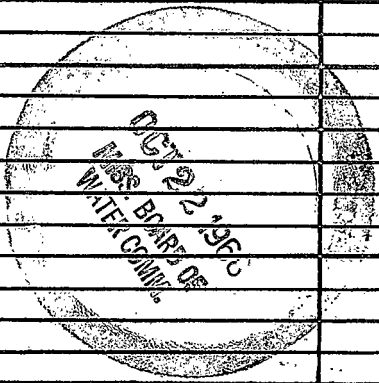

DRILLERS REMARKS:

