

CODED

MISSISSIPPI
BOARD OF WATER COMMISSIONERS
416 North State Street
Jackson, Mississippi 39201

WATER WELL DRILLERS LOG

Yazoo Co
K42
7-69

July 30 1969 date well completed
Cannell Drilling Yazoo firm name
Yazoo county well located

LANDOWNER: James Taylor

description of formations encountered	from	to
Clay	0	80
Sand & Gravel	80	90
Blue Clay	90	300
sand	300	360

(mailing address)

WELL LOCATION:

sec ~~10~~ ¹¹ T ~~11~~ N ₅ R ~~3~~ ³ E
W
3 miles N of Tinsley
(distance) (direction) (nearest town)

WELL PURPOSE: Home
(home, irrigation, municipal, industrial)


WELL COMPLETION DATA:

- (1) diameter (inches) 2"
- (2) total depth (feet) 360
- (3) static water level (feet) 218 below top of ground.
- (4) casing steel, 350 (material) (depth)
2" If telescope see back. (size)
- (5) screen 10' , 350 to 360 (length) (depth to top)
2" , Stainless Steel (size) (material)
- (6) pump 2 (HP) 1 1/2 (yield gpm)
Eject. (type power)
- (7) electric log NO (yes or no)

(organization running log)


(8) how well bottom plugged
Back wash Valve

DRILLERS REMARKS:

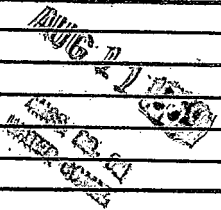

If well telescopes please sketch and show depths.

GROUND LEVEL

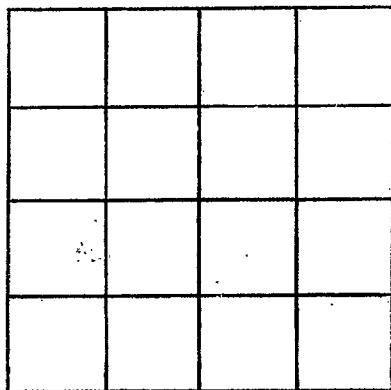

SECTION _____

Please indicate well location X.

ADDITIONAL INFORMATION

If more than one screen, show locations of each on sketch.