

MISSISSIPPI
BOARD OF WATER COMMISSIONERS
416 North State Street
Jackson, Mississippi 39201

CODED

WATER WELL DRILLERS LOG

Y1200
K43
8-23-69

8-23-1969 date well completed
M. C. Connell Drilling Co. firm name
Yazoo county well located

LANDOWNER:

D. M. Horne
Valley Miss.
(mailing address)

description of formations encountered

from to

clay (Red & Yellow)	0	92
sandy clay gravel	92	111
blue clay	111	392
sand	392	423
hard shale	423	425

WELL LOCATION:

sec. 37 T. 11 N. R. 2 E
W
1 1/2 miles S.E. of Crump
(distance) (direction) (nearest town)

WELL PURPOSE: Home
(home, irrigation, municipal, industrial)

WELL COMPLETION DATA:

- (1) diameter (inches) 4 x 2"
- (2) total depth (feet) 425'
- (3) static water level (feet) _____ below above top of ground.
- (4) casing steel 394'
(material) (depth)
4 x 2" if telescope see back.
(size)
- (5) screen 20' 394'
(length) (depth to top)
2" stainless steel
(size) (material)
- (6) pump 1 1/2 12
(HP) (yield gpm)
elect.
(type power)
- (7) electric log No
(yes or no)

(organization running log)


(8) how well bottom plugged
Back Wash Valve

DRILLERS REMARKS:

AUG 26 1969

MISS. BD. OF WATER COMMISSIONERS

If well telescopes please sketch and show depths.

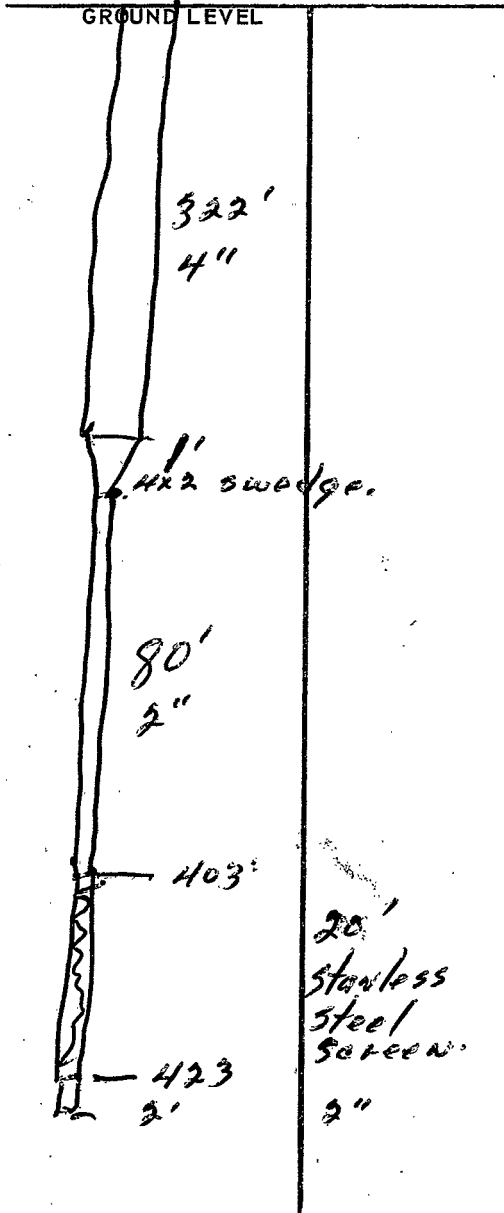

X			

SECTION 25

Please indicate well location X.

ADDITIONAL INFORMATION

If more than one screen, show locations of each on sketch.