

MISSISSIPPI DEPARTMENT OF NATURAL RESOURCES
 Bureau of Land and Water Resources
 Southport Mall
 P.O. Box 10631
 Jackson, Mississippi 39209
WATER WELL DRILLERS LOG

CODED

42200
K-26
7/25/80

July 25 1980 E.M. "Bud" Cresswell 42200
 date well completed firm name county well located

LANDOWNER:
J. R. Hart
Spartan, Ms.
 (mailing address)

description of formations encountered	from	to
<u>Clay</u>	<u>0</u>	<u>30</u>
<u>Sand - gravel</u>	<u>30</u>	<u>170</u>
<u>Clay</u>	<u>170</u>	<u>280</u>
<u>Reddish Shale</u>	<u>280</u>	<u>480</u>
<u>Shale</u>	<u>480</u>	<u>820</u>
<u>Sand</u>	<u>820</u>	<u>920</u>

WELL LOCATION:
 sec. 4 T. 10 N R. 3 W
5 miles S of Yazoo
 (distance) (direction) (nearest town)

WELL PURPOSE: Home
 (home, irrigation, municipal, industrial)


- WELL COMPLETION DATA:
- (1) diameter (inches) 4
 - (2) total depth (feet) 920
 - (3) static water level (feet) 18 below top of ground.
 - (4) casing Steel, 890,
 (material) (depth)
4 if telescope see back.
 (size)
 - (5) screen 30, 890
 (length) (depth to top)
2, Stainless
 (size) (material)
 - (6) pump 1/2, 40
 (HP) (yield gpm)
0
 (type power)
 - (7) electric log No.
 (yes or no)
 (organization running log)
 - (8) how well bottom/plugged
Blank shale

DRILLERS REMARKS:

DEPT. OF NATURAL RESOURCES
 BUREAU OF LAND & WATER RESOURCES
 JUL 29 1980
RECEIVED

If well telescopes please sketch and show depths.

GROUND LEVEL

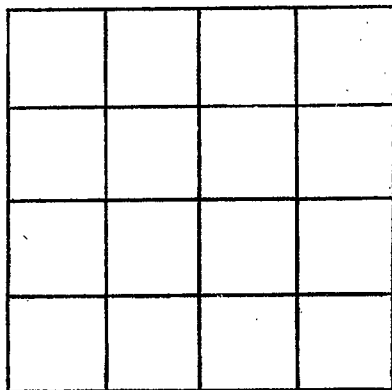

SECTION _____

Please indicate well location X.

ADDITIONAL INFORMATION

If more than one screen,
show locations of each on sketch.