

MISSISSIPPI DEPARTMENT OF NATURAL RESOURCES

Bureau of Land and Water Resources

Southport Mall

P.O. Box 10631

Jackson, Mississippi 39209-0631

WATER WELL DRILLERS LOG

Yazoo  
R 47  
9-25-81

9-25

date well completed

1981 Dyer Well + Irrigation

firm name

YAZOO

county well located

LANDOWNER: David Hogue

description of formations encountered

from

to

Yazoo City, Miss.  
(mailing address)

Clay 0 28  
fine sand 28 65  
sand + gravel 65 113

WELL LOCATION:

sec. 1 T 11 N R 3 E  
S W  
2 miles SW of Yazoo City  
(distance) (direction) (nearest town)

WELL PURPOSE: Irrigation  
(home, irrigation, municipal, industrial)

WELL COMPLETION DATA:

- (1) diameter (inches) 16"
- (2) total depth (feet) 113
- (3) static water level (feet) 22 below top of ground.
- (4) casing Steel, 73,  
(material) (depth)  
16" if telescope see back.  
(size)
- (5) screen 40', 73  
(length) (depth to top)  
16", Mild Steel  
(size) (material)
- (6) pump 60 3000  
(HP) (yield gpm)  
Diesel  
(type power)
- (7) electric log No  
(yes or no)  
None  
(organization running log)
- (8) how well bottom plugged Plate

CODED

DEPT. OF NATURAL RESOURCES  
BUREAU OF LAND & WATER RESOURCES


NOV 8 - 1981

RECEIVED

DRILLERS REMARKS:

If well telescopes please sketch and show depths.

GROUND LEVEL

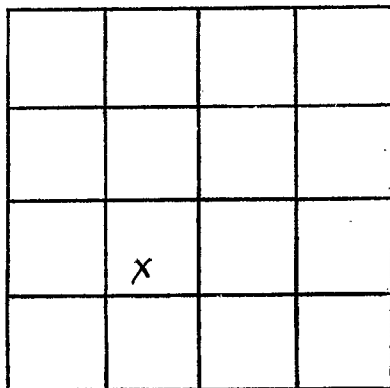

SECTION 1

Please indicate well location X.

ADDITIONAL INFORMATION

If more than one screen, show locations of each on sketch.