

MISSISSIPPI DEPARTMENT OF NATURAL RESOURCES

Bureau of Land and Water Resources

Southport Mall

P.O. Box 10631

Jackson, Mississippi 39209

WATER WELL DRILLERS LOG

CODED

YAZOO
K 48
111183

date well completed 19 1983 firm name Super Well + Inc county well located Yazoo

LANDOWNER: Dennis Paul
Yazoo City, MS
(mailing address)

description of formations encountered	from	to
<u>Clay</u>	<u>0</u>	<u>24</u>
<u>Fin Sand</u>	<u>24</u>	<u>58</u>
<u>Sand & Gravel</u>	<u>58</u>	<u>113</u>

WELL LOCATION:
sec. 16 T 11 N R. 3 E
S 6 miles S/W of HAZOO
(distance) (direction) (nearest town)

WELL PURPOSE:
(home, irrigation, municipal, industrial)

WELL COMPLETION DATA:

(1) diameter (inches) 16"

(2) total depth (feet) 113

(3) static water level (feet) 19 below above top of ground.

(4) casing steel (material), (depth) _____
(size) if telescope see back.

(5) screen 40 (length), 300 (depth to top)
(size) (material)

(6) pump 1/2 (HP), 3000 (yield gpm)
(type power)

(7) electric log _____ (yes or no)
(organization running log)

(8) how well bottom plugged _____

DRILLERS REMARKS: _____

CODED

DEPT. OF NATURAL RESOURCES
BUREAU OF LAND & WATER RESOURCES


NOV 28 1983

RECEIVED

④

If well telescopes please sketch and show depths.

GROUND LEVEL

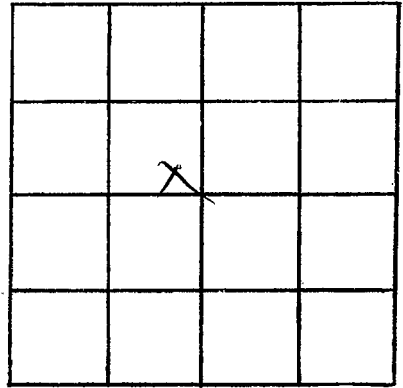

SECTION _____

Please indicate well location X.

ADDITIONAL INFORMATION

If more than one screen, show locations of each on sketch.