

MISSISSIPPI DEPARTMENT OF NATURAL RESOURCES

Bureau of Land and Water Resources

Southport Mall

P.O. Box 10631

Jackson, Mississippi 39209

WATER WELL DRILLERS LOG

CODED

YA 700  
K 49  
5-23-84

5-23-84 19 IRRIGATION Equipment YA 200  
date well completed firm name county well located

LANDOWNER: Jay Stricklin  
Rugby Plantation  
YA 200 City, MS 39194  
For Delta Imp. (mailing address)

description of formations encountered	from	to
Clay	0	33
Sand	33	63
Coarse sand/gravel	63	105

WELL LOCATION:  
sec 21 T 11 N R 3 E  
6 miles SW of YA 200 City  
(distance) (direction) (nearest town)

WELL PURPOSE: Irrigation  
(home, irrigation, municipal, industrial)

- WELL COMPLETION DATA:
- (1) diameter (inches) 12"
  - (2) total depth (feet) 105'
  - (3) static water level (feet) 19' below above top of ground.
  - (4) casing Steel 65'  
(material) (depth)  
(size) if telescope see back.
  - (5) screen 40' 65'  
(length) (depth to top)  
12" steel  
(size) (material)
  - (6) pump \_\_\_\_\_ (HP) \_\_\_\_\_ (yield gpm)  
(type power)
  - (7) electric log \_\_\_\_\_ (yes or no)  
(organization running log)
  - (8) how well bottom plugged steel plate

CODED

DEPT. OF NATURAL RESOURCES  
BUREAU OF LAND & WATER RESOURCES


SEP 26 1984

RECEIVED

DRILLERS REMARKS:

If well telescopes please sketch and show depths.

GROUND LEVEL

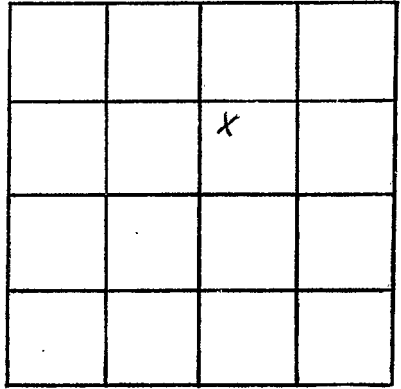

SECTION 21

Please indicate well location X.

ADDITIONAL INFORMATION

If more than one screen, show locations of each on sketch.