

MISSISSIPPI DEPARTMENT OF ENVIRONMENTAL QUALITY
Bureau of Land and Water Resources

P. O. Box 10631
Jackson, MS 39289-0631
WATER WELL DRILLERS LOG

COUNTY WELL LOCATED YA200	
WELL NUMBER R 54	CODED V
DATE WELL COMPLETED June 24, 1992	

PERMIT NUMBER
NAME OF DRILLING FIRM E.M. Bud Cresswell
BENTONIA, MS-39040

NAME & MAILING ADDRESS OF LANDOWNER Energy Drilling NATCHEZ, MS-		
WELL LOCATION: SEC	TOWNSHIP	RANGE
18	11 N	3 W
DISTANCE	DIRECTION	NEAREST TOWN
5 Miles	SW	of YA200 City
OTHER LANDMARK		
WELL PURPOSE: Home, Irrigation, Municipal, Industrial, Fish Pond, etc. oil well supply		

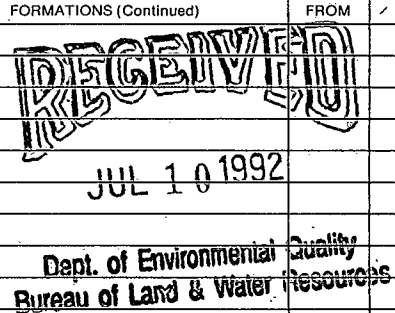
PUMP DATA		
PUMP TYPE (Circle One): Submersible, Turbine, Jet, Flowing Well, Other (Describe) AIR COMPRESSOR		
POWER TYPE (Circle One): Electric, Tractor, Diesel, Gasoline, Butane, Other (Describe) _____ H/P _____		
Pump Capacity (GPM)	No. of Stages	Setting Depth FT.
PUMP TEST		
Well yielded 75 GPM with a drawdown of 10 ft. after 1/2 hours of pumping		

WELL DATA		
Well Depth 90	Casing Diameter (In.) 3	Casing Length (Ft.) 70
Type of Casing PVC	Hole Depth 90	Depth to Static Water Level 12
TYPE OF COMPLETION: (Circle One or More): Natural Development , Gravel Packed, Underreamed, Telescoped, Open Hole, Other		
Top of Lap Pipe or Reduction in Casing FEET		
IF TELESCOPED OR MORE THAN ONE SCREEN: USE BACK PAGE		

LOG DATA	
TYPE OF LOG RUN (Circle One): Electric, Gamma Ray, Density, Sonic, Neutron, Other (Describe) NO	
Name of Organization Running Log	
No Log Run.	

SCREEN DATA		
Diameter - Inches 3	Length - Feet 20	Slot Size - Inches .020
Screen Type PVC	Depth to Bottom - Feet 90	

GEOLOGIC DATA (Office Use Only)			
Surface Elev.	Geologic Unit	Unit Thickness	Depth to Top
Subs. SWL	Date	Analysis	Aquifer Test
Driller's Remarks PARAMONT USA 18-7 2100'S & 1500' w of NB/COB			

DESCRIPTION OF FORMATIONS ENCOUNTERED	FROM	TO	FORMATIONS (Continued)	FROM	TO
gumbo - SAND-GRAVEL	0	55			
	55	90			

IF MORE SPACE IS NEEDED, USE BACK

If well telescopes please
sketch and show depths.

GROUND LEVEL

SECTION _____

Please indicate well location X.

ADDITIONAL INFORMATION

If more than one screen,
show location of each on sketch.