

188C

MISSISSIPPI DEPARTMENT OF ENVIRONMENTAL QUALITY

Office of Land and Water Resources

P. O. Box 10631
Jackson, MS 39289-0631
WATER WELL DRILLERS LOG

COUNTY WELL LOCATED Yazoo
WELL NUMBER / CODED HA X57
Lammons
DATE WELL COMPLETED

PERMIT NUMBER 453
NAME OF DRILLING FIRM Morphis Brothers
Trout, LA 71371

NAME & MAILING ADDRESS OF LANDOWNER Hunt Petroleum P.O. Box 240 Trout, LA 71371
WELL LOCATION: SEC TOWNSHIP RANGE 705 N + 36 11 N 3 E 99 W + S W
DISTANCE DIRECTION NEAREST TOWN 5 Miles SE of Tinsley
OTHER LANDMARK Old Tinsley Rd
WELL PURPOSE: Home, Irrigation, Municipal, Industrial, Fish Pond, etc. Rig Supply

PUMP DATA		
PUMP TYPE (Circle One): <input checked="" type="checkbox"/> Submersible Turbine Jet Flowing Well, Other (Describe)		
POWER TYPE (Circle One): <input checked="" type="checkbox"/> Electric Tractor Diesel Gasoline Butane Other (Describe) H/P 10 460V		
Pump Capacity (GPM)	No. of Stages	Setting Depth
		FT.
PUMP TEST		
Well yielded 100 GPM with a drawdown of _____ ft. after _____ hours of pumping		

WELL DATA		
Well Depth 420	Casing Diameter (In.) 4	Casing Length (Ft.) 360
Type of Casing PVC	Hole Depth 420	Depth to Static Water Level 80
TYPE OF COMPLETION: (Circle One or More): <input checked="" type="checkbox"/> Gravel Packed, Underreamed, Telescoped, Natural Development; Open Hole, Other (Describe)		

LOG DATA	
TYPE OF LOG RUN (Circle One): No Log Run, Electric, Gamma Ray, Density, Sonic, Neutron, Other (Describe)	
Name of Organization Running Log	

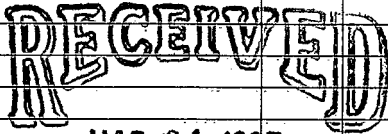
WELL GROUTED TO A DEPTH OF 10 FEET Type Grout (circle one): Cement, Bentonite, or Mix
--

GEOLOGIC DATA (Office Use Only)			
Surface Elev.	Geologic Unit	Unit Thickness	Depth to Top'
Subs. SWL	Date	Analysis	Aquifer Test

SCREEN DATA		
Diameter - Inches 4	Length - Feet 60	Slot Size - Inches .014
Screen Type PVC	Depth to Bottom - Feet -	

Driller's Remarks

DESCRIPTION OF FORMATIONS ENCOUNTERED	FROM	TO
Sandy brown clay	0	20
Brown sand w/ clay brks	20	40
Coarse sd + gravel	40	67
Blue Clay	67	160
Sandy gray clay w/ rock streaks	160	240
Sand stone	240	250
Sandy clay	250	298
Fine gray sand w/ c.b.	298	320
Fine gray + med sd.	320	420

FORMATIONS (Continued)	FROM	TO
 MAR 31 1997 Dept. of Environmental Quality Office of Land & Water Resources		

IF MORE SPACE IS NEEDED, USE BACK

If well telescopes please sketch and show depths.

GROUND LEVEL

SECTION _____

Please indicate well location X.

ADDITIONAL INFORMATION

If more than one screen,
show location of each on sketch.