

MISSISSIPPI BOARD OF WATER COMMISSIONERS

YA200

K 2001

1-66

WATER WELL DRILLERS LOG

Date: Jan, 1966, Driller: David Benning County: Yazoo
(Name)

(1) Owner of Land: Jasper & Robert Chisholm
(Name)
Yazoo City, Miss
(Address)
 (2) Location: NE NE SW
1/4, 1/4, Sec. 14 T11N R34E
8 miles SW, of Yazoo City
(distance) (direction) (Nearest Town)
 (3) Topography: Hilly
(Hilly) (Flat) (Level)
 (4) Purpose of Well: Industrial
(Domestic Irrigation Municipal, Industrial, Other)

Description & Color of Materials Sand, Clay, Red Clay, Shell, etc.	Thickness Feet	Depth Feet
top soil & clay	18	18
clay	20	38
sand & gravel	20	58
gravel	20	78
gravel	10	88
clay	10	98
clay	20	118
clay	20	138
clay	20	158
clay	20	178
clay	20	198
clay	20	218
clay	20	238
clay	20	258
clay	20	278
sand	20	298
sandy shale with sand beds	20	318
sandy shale with sand beds	20	338
shale	20	358
shale with small beds sand	20	378
shale	20	398
shale with small layers rock	20	418
shale	20	438
shale	20	458
shale	20	478
shale rock (shale) rock	20	498
sand with shale on top	20	518
shale	20	538


Information upon completion of well:

(1) Diameter 2 inches.
 (2) Total Depth 538 feet.
 (3) Water Level _____ feet below top of ground.
 (4) Cased to 510, Size 2"
 (5) Screen: Size 2", Length 20'
 (6) Were any formations sealed against pollution?
 _____ yes, _____ no.

If YES depth of formation _____

Why _____

Drillers Remarks: _____

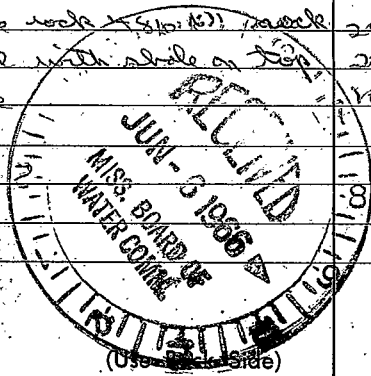

Well No.

1870

1871

1872

1873

1874

1875

1876

1877

1878

1879