

Ya300  
 K 2000  
 7-67  
 Elec 109

MISSISSIPPI  
 BOARD OF WATER COMMISSIONERS  
 416 North State Street  
 Jackson, Mississippi 39201

WATER WELL DRILLERS LOG

7-20-67 1967 Bud Cresswell Ya200  
 date well completed firm name county well located

LANDOWNER:

A. B. Light CAP  
 Yazoo City, Mississippi  
 (mailing address)

description of formations encountered

	from	to
Top soil	0	15
bank	15	60
shale	60	260
sandy shale	260	440
loam shale	440	490
sandy shale	490	590
shale	590	780
sand	780	800
shale	800	875
sand	875	1078

WELL LOCATION: Near N.W. cor., NW, SE


sec. 10 T. 11 N. R. 3 E. S. 3  
 4 miles S.W. of Yazoo City  
 (distance) (direction) (nearest town)

WELL PURPOSE: Domestic  
 (home, irrigation/municipal, industrial)

WELL COMPLETION DATA:

- (1) diameter (inches) 4 x 2
- (2) total depth (feet) 1078
- (3) static water level (feet) 15 below above top of ground.
- (4) casing Steel, 1048 (material), (depth)  
 4x2 (size) if telescope see back.
- (5) screen 30, 1048 (length), (depth to top)  
 .008, Stainless Steel (size), (material)
- (6) pump 20 (HP), (yield gpm)  
 Elec (type power)
- (7) electric log yes (yes or no)  
 State (organization running log)
- (8) how well bottom plugged Drop Plug

DRILLERS REMARKS:

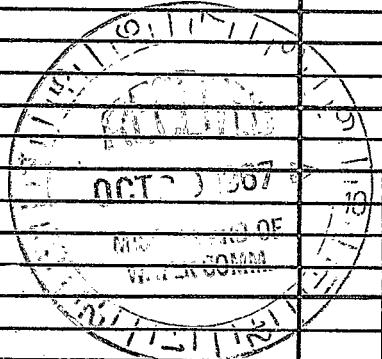

If well telescopes please sketch and show depths.


GROUND LEVEL

4"  
120'

2"  
928

30'  
2" screen  
008 SS

If more than one screen,  
show locations of each on sketch.

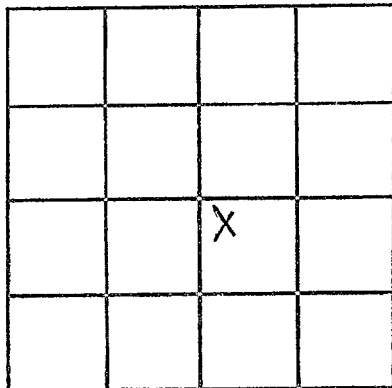

SECTION 10

Please indicate well location X.

ADDITIONAL INFORMATION

Lined area for additional information.