

MISSISSIPPI DEPARTMENT OF NATURAL RESOURCES

Bureau of Land and Water Resources

Southport Mall

P.O. Box 10631

Jackson, Mississippi 39209

WATER WELL DRILLERS LOG

Yazoo
K2003

July 28 1987 87 E.A. Bud RESWELL YAZOO
 date, well completed firm name county well located

LANDOWNER:	description of formations encountered	from	to
H. J. Grey	Dirt	0	70
Yazoo City, Ms. 39194 (mailing address)	Sand - gravel Wagon Road	70	85
WELL LOCATION:	Trencher Branch	85	200
sec. <u>25</u> T <u>11</u> N R <u>3</u> E <u>4</u> miles South Yazoo City (distance) (direction) of (nearest town)	Sandy shale	200	220
WELL PURPOSE: <u>None</u> (home, irrigation, municipal, industrial)	Thin sand	220	380
WELL COMPLETION DATA:	Sand	380	400
(1) diameter (inches) <u>4</u>		400	440
(2) total depth (feet) <u>430</u>			
(3) static water level (feet) <u>250</u> below top of ground.			
(4) casing <u>PVC</u> <u>400</u> (material) (depth)			
<u>4</u> (size) if telescope see back.			
(5) screen <u>30</u> <u>400</u> (length) (depth to top)			
<u>4</u> <u>PVC</u> (size) (material)			
(6) pump <u>1 1/2</u> <u>15</u> (HP) (yield gpm)			
(type power)			
(7) electric log <u>no</u> (yes or no)			
(organization running log)			
(8) how well bottom plugged <u>Sand pack</u>			
DRILLERS REMARKS:			


RECEIVED

AUG 26 1987

Department of Natural Resources
Bureau of Land & Water Resources

If well telescopes please sketch and show depths.

GROUND LEVEL

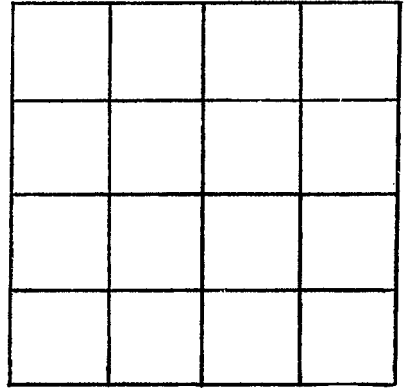

SECTION _____

Please indicate well location X.

ADDITIONAL INFORMATION

If more than one screen,
show locations of each on sketch.