

**MISSISSIPPI DEPARTMENT OF ENVIRONMENTAL  
QUALITY**

Office of Land and Water Resources

P. O. Box 10631  
Jackson, MS 39289-0631  
**WATER WELL DRILLERS LOG**

COUNTY WELL LOCATED  
9A200

WELL NUMBER 1K CODED

DATE WELL COMPLETED  
2008  
June 3, 1994

PERMIT NUMBER

NAME OF DRILLING FIRM  
K M Bud CRESSWELL

BENTONIA, MS

NAME & MAILING ADDRESS OF LANDOWNER  
George McKenzie  
2019 McKenzie Rd  
McComb, MS. 39648

WELL LOCATION: SEC 20 TOWNSHIP 11 RANGE N 3 W

DISTANCE 5 MILES DIRECTION South of NEAREST TOWN Yazoo City

OTHER LANDMARK

WELL PURPOSE:  Home Irrigation,  Municipal,  Industrial,  Fish Pond, etc.

**PUMP DATA**

PUMP TYPE (Circle One):  
 Submersible  Turbine  Jet  Flowing Well,  
Other (Describe)

POWER TYPE (Circle One):  
 Electric  Tractor  Diesel  Gasoline  Butane,  
Other (Describe) H/P 1

Pump Capacity (GPM) 20 No. of Stages 12 Setting Depth 63 FT.

PUMP TEST  
Well yielded 50 GPM with  
a drawdown of 10 ft.  
after 1/2 hours of pumping

**WELL DATA**

Well Depth 110 Casing Diameter (In.) 4 Casing Length (Ft.) 90

Type of Casing PVC Hole Depth 120 Depth to Static Water Level 12

TYPE OF COMPLETION: (Circle One or More):  
 Gravel Packed,  Underreamed,  Telescoped,  
 Natural Development,  Open Hole,  Other  
(Describe)

WELL GROUTED TO A DEPTH OF 12 FEET  
Type Grout (circle one):  Cement,  Bentonite, or Mix

**LOG DATA**

TYPE OF LOG RUN (Circle One):  
 Electric,  Gamma Ray,  Density,  No Log Run,  
 Sonic,  Neutron,  
Other (Describe)

Name of Organization Running Log

**SCREEN DATA**

Diameter - Inches 4 Length - Feet 20 Slot Size - Inches .010

Screen Type PVC Depth to Bottom - Feet 110

**GEOLOGIC DATA (Office Use Only)**

Surface Elev.	Geologic Unit	Unit Thickness	Depth to Top
Subs. SWL	Date	Analysis	Aquifer Test

Driller's Remarks

Top of Lap Pipe or Reduction in Casing


FEET  IF TELESCOPED OR MORE THAN ONE SCREEN: USE BACK PAGE

DESCRIPTION OF FORMATIONS ENCOUNTERED	FROM	TO
<u>Surface Deposit</u>	<u>0</u>	<u>40</u>
<u>Sand-gravel</u>	<u>40</u>	<u>110</u>
<u>Clay</u>	<u>110</u>	<u>120</u>

FORMATIONS (Continued)	FROM	TO
<b>RECEIVED</b>		
<b>JUN 13 1994</b>		
Dept. of Enviro. Quality Office of Land & Water Resources		
IF MORE SPACE IS NEEDED, USE BACK.		

If well telescopes please sketch and show depths.

GROUND LEVEL

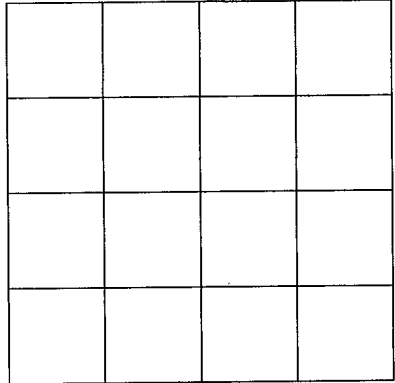

SECTION \_\_\_\_\_

Please indicate well location X.

ADDITIONAL INFORMATION

If more than one screen,  
show location of each on sketch.