

YA200

L

WATER WELL DRILLERS LOG

11-10-65

Date: Nov 10, 1965, Driller: M<sup>rs</sup> Kay, County Yazoo

(1) Owner of Land: Mr. Herron  
 (Name)  
Yazoo City  
 (Address)

(2) Location: \_\_\_\_\_ 1/4, \_\_\_\_\_ 1/4, Sec. \_\_\_\_\_ T. R. \_\_\_\_\_  
6 miles S of Yazoo City  
 (distance) (direction) (Nearest Town)

(3) Topography: \_\_\_\_\_  
 (Hilly) (Flat) (Level)

(4) Purpose of Well: Home  
 (Domestic, Irrigation, Municipal, Industrial, Other)

Description & Color of Materials Sand, Clay, Red Clay, Shell, etc.	Thick- ness Feet	Depth Feet
<u>Clay</u>	<u>0</u>	<u>20</u>
<u>Thin Rock</u>	<u>20</u>	<u>40</u>
<u>Thin Rock</u>	<u>40</u>	<u>60</u>
<u>Thin Rock</u>	<u>60</u>	<u>80</u>
<u>Shale</u>	<u>80</u>	<u>200</u>
<u>Shale</u>	<u>200</u>	<u>220</u>
<u>Shale and Sand</u>	<u>220</u>	<u>240</u>
<u>Med. Sand</u>	<u>240</u>	<u>315</u>

Information upon completion of well:

(1) Diameter 2 inches.

(2) Total Depth 315 feet.

(3) Water Level 66 feet below top of ground.

(4) Cased to \_\_\_\_\_, Size \_\_\_\_\_

(5) Screen: Size 007; Length 20


(6) Were any formations sealed against pollution?  
 \_\_\_\_\_ yes,  no.

If YES depth of formation \_\_\_\_\_

Why \_\_\_\_\_

Drillers Remarks: \_\_\_\_\_

3HP am unit

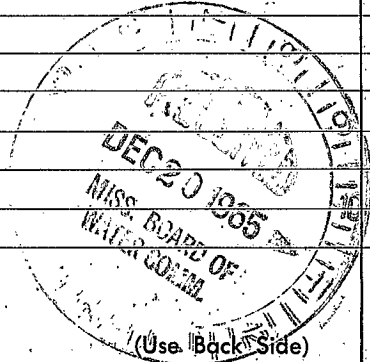

Well No.

