

YAZOO
L2
7-1-71

MISSISSIPPI
BOARD OF WATER COMMISSIONERS
416 North State Street
Jackson, Mississippi 39201

CODED

WATER WELL DRILLERS LOG

July 1, 1971 date well completed
E.M. "Bud" Crumley firm name
Yazoo county well located


LANDOWNER:	description of formations encountered	from	to
Floyd High Yazoo City, Miss. (mailing address)			
WELL LOCATION:	CODED		
sec 6 T 11 N R 2 E 2 miles S of Yazoo City (distance) (direction) (nearest town)			
WELL PURPOSE: home (home, irrigation, municipal, industrial)			
WELL COMPLETION DATA:			
(1) diameter (inches) 2			
(2) total depth (feet) 900			
(3) static water level (feet) 26 below top of ground			
(4) casing: steel 870 (material) (depth) 2 (size) if telescope see back.			
(5) screen: 30 870 (length) (depth to top) 2 Standen (size) (material)			
(6) pump: 3/4 20 (HP) (yield gpm)			
(7) electric log No (yes or no) A (organization running log)			
(8) how well bottom plugged Plug plug			
DRILLERS REMARKS:			

JUL 6 1971

MISSISSIPPI BOARD OF WATER COMMISSIONERS

If well telescopes please sketch and show depths.

GROUND LEVEL

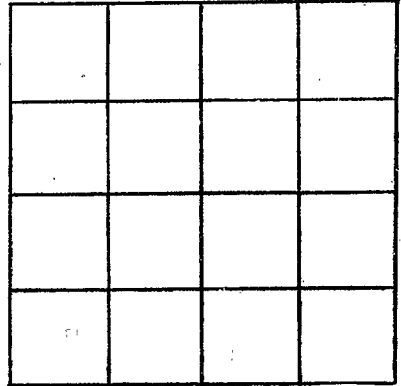

SECTION _____

Please indicate well location X.

ADDITIONAL INFORMATION

If more than one screen, show locations of each on sketch.