

**YA200**

**L 13**

**7-30-62**

**WATER WELL DRILLERS LOG**

CODED

Date: July 30, 1962, Driller: J. G. BARNES County: Yazoo  
(Name)

(1) Owner of Land: JULIUS HEWITSON  
(Name)

Rt #3 Yazoo City  
(Address)

(2) Location: SE 1/4, NE 1/4, Sec. 33 T11 R24

6 miles SE of YAZOO CITY  
(distance) (direction) (Nearest Town)

(3) Topography: Hilly  
(Hilly) (Flat) (Level)

(4) Purpose of Well: FARM  
(Domestic Irrigation Municipal, Industrial, Other)

Description & Color of Materials Sand, Clay, Red Clay, Shell, etc.	Thick-ness Feet	Depth Feet
DARK BROWN CLAY	4'	4'
YELLOW CLAY	21'	25'
BLUE CLAY	66'	91'
SHELLS & SAND MILLED CLAY W/SD. (MB)	54'	145'
DARK BROWN SHALE	156'	301'
COCKFIELD WATER SD.	75'	376'
T.P.		475'

**Information upon completion of well:**


- (1) Diameter 2 inches.  
 (2) Total Depth 475 feet.  
 (3) Water Level 105 ft. feet below top of ground.  
 (4) Cased to 465 ft., Size 2 in.  
 (5) Screen: Size 100 mesh, Length 10 ft.  
 (6) Were any formations sealed against pollution?

         yes,          no.

If YES depth of formation         

Why         

Drillers Remarks:         

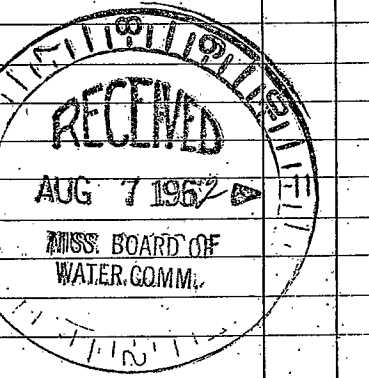

(Use Back Side)

Well No.

..... V.

.....  
.....  
