

Ya 300
L15
12-66

MISSISSIPPI
BOARD OF WATER COMMISSIONERS
416 North State Street
Jackson, Mississippi 39201

CODED

WATER WELL DRILLERS LOG

1966-11-14 date well completed
1966 J. H. Barnes Drilling Co. Yazoo firm name
Yazoo county well located

LANDOWNER: David Elzey
Yazoo City #R+1
Miss.
(mailing address)


WELL LOCATION:
sec 31 T 11 N. R 2 W E
S W
3 miles N-E of TINSLEY
(distance) (direction) (nearest town)

WELL PURPOSE:
(home, irrigation, municipal, industrial)

WELL COMPLETION DATA:
(1) diameter (inches) 4"
(2) total depth (feet) 1127
(3) static water level (feet) 270 below above top of ground. 1127
(4) casing _____ (material) _____ (depth) _____
4x2 if telescope see back. (size)
(5) screen 30 _____, 1091 _____ (length) (depth to top)
2" _____, Stainless Steel _____ (size) (material)
(6) pump 1 _____, 15 _____ (HP) (yield gpm)
23060 (type power)
(7) electric log no _____ (yes or no)

(organization running log)
(8) how well bottom plugged _____

description of formations encountered	from	to
top soil	47	47
Red clay	20	67
Sand & pea gravel	41	108
Yazoo clay	312	420
Sand & shell	75	495
Shell	1	501
Pea	1	502
Sand	298	800
Braun shell	90	890
Pea & shell	30	920
Sand & shell	115	965
Spatter sand	157	1122

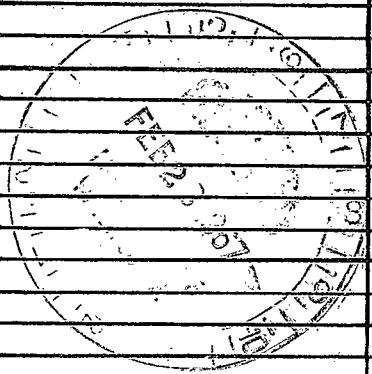

DRILLERS REMARKS:

If well telescopes please sketch and show depths.

GROUND LEVEL

Submersible
Pumps 1 H.P.

400
feet
4"

2"
Pipes

30 feet
Screen

	X		

SECTION 31

Please indicate well location X.

ADDITIONAL INFORMATION

If more than one screen,
show locations of each on sketch.