

Yazoo
L 16
3-23-70

MISSISSIPPI
BOARD OF WATER COMMISSIONERS
416 North State Street
Jackson, Mississippi 39201

WATER WELL DRILLERS LOG

CODED

March 23 1970 McConnell Drilling Co. Yazoo.
date well completed firm name county well located

LANDOWNER: L. A. McCreary

Yazoo City, Miss

(mailing address)

WELL LOCATION:

sec. 7 T. 11 (N) R. 2 (E)
4 miles Southeast of Yazoo City
(distance) (direction) (nearest town)

WELL PURPOSE:

(home, irrigation, municipal, industrial)

WELL COMPLETION DATA:

- (1) diameter (inches) 2"
- (2) total depth (feet) 405'
- (3) static water level (feet) 110' below above top of ground.
- (4) casing Steel, 395',
(material) (depth)
2" if telescope see back.
(size)
- (5) screen 10', 395'
(length) (depth to top)
2", Stainless Steel
(size) (material)
- (6) pump 3 200
(HP) (yield gpm)
Elect. (AIP)
(type power)
- (7) electric log No
(yes or no)

(organization running log)

(8) how well bottom plugged:
Backwash Valve.

DRILLERS REMARKS:

Air well.

description of formations encountered

from to

<u>Red & Yellow Clay</u>	<u>0</u>	<u>80</u>
<u>sand & Gravel</u>	<u>80</u>	<u>85</u>
<u>Blue clay</u>	<u>85</u>	<u>360</u>
<u>fine sand.</u>	<u>360</u>	<u>390</u>
<u>Coarse Sand.</u>	<u>390</u>	<u>405</u>


CODED

APR - 8 1970

MOS. B.
W/A

If well telescopes please sketch and show depths.

GROUND LEVEL

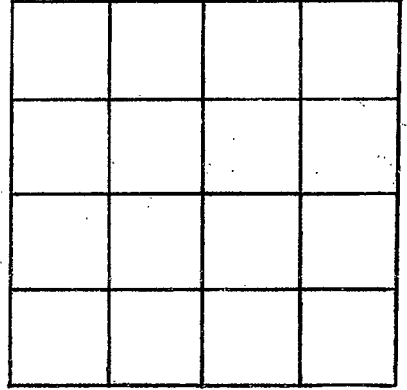

SECTION _____

Please indicate well location X.

ADDITIONAL INFORMATION

If more than one screen, show locations of each on sketch.