

MISSISSIPPI  
BOARD OF WATER COMMISSIONERS  
416 North State Street  
Jackson, Mississippi 39201

**CODED**

WATER WELL DRILLERS LOG

Yazoo  
L 17  
6-18-70

6-18-1970 F.M. "Bud" Crosswell Yazoo  
date well completed firm name county well located

LANDOWNER:

Mrs. A.D. Payne  
Rt. 3  
Yazoo City, Miss.  
(mailing address)

description of formations encountered

from to

CLAY  
SAND / gravel  
0 80  
80 105

WELL LOCATION:

sec. 35 T 11 N R 2  
5 miles South of Yazoo City  
(distance) (direction) (nearest town)

WELL PURPOSE: Home  
(home, irrigation, municipal, industrial)

WELL COMPLETION DATA:

- (1) diameter (inches) 2  
(2) total depth (feet) 105  
(3) static water level (feet) 90 below top of ground.  
(4) casing steel, 100 (material), (depth)  
2 (size) if telescope see back.  
(5) screen 5 ft., 100 ft. (length), (depth to top)  
2 stainless (size), (material)  
(6) pump 1 1/2 (HP), 5 (estimate) (yield gpm)  
0 (type power)  
(7) electric log no (yes or no)  
0 (organization running log)

**CODED**

JUN 23 1970


(8) how well bottom plugged  
steel plug

MISS. BD. OF  
WATER COMMISSIONERS

DRILLERS REMARKS:

If well telescopes please sketch and show depths.

GROUND LEVEL

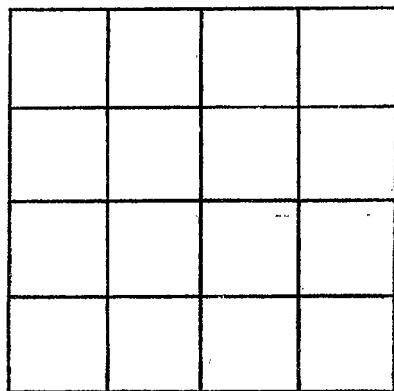

SECTION \_\_\_\_\_

Please indicate well location X.

ADDITIONAL INFORMATION

If more than one screen,  
show locations of each on sketch.