

Yazoo
L18
6-21-70

MISSISSIPPI
BOARD OF WATER COMMISSIONERS
416 North State Street
Jackson, Mississippi 39201

CODED

WATER WELL DRILLERS LOG
DYER WELL & IRRIGATION SERVICE

6-21-70 19 date well completed Yazoo firm name Yazoo county well located

LANDOWNER:
T. R. Coleman
Yazoo City, Miss.
(mailing address)

description of formations encountered	from to	
	feet	feet
Clay	0	23
Coarse Brown Sand	23	43
Medium Sand	43	73
Coarse Sand	73	83
Sand & Pea Gravel	83	113

WELL LOCATION:
sec. 6 T. 11 N. R. 2 E.
2 miles SW of Yazoo City
(distance) (direction) (nearest town)

WELL PURPOSE: Ind
(home, irrigation, municipal, industrial)

CODED

WELL COMPLETION DATA:

(1) diameter (inches) 16"

(2) total depth (feet) 113

(3) static water level (feet) 19 below top of ground.

(4) casing Steel, 73' (depth), 16" (size) if telescope see back.

(5) screen 40' (length), 73' (depth to top), 16" (size), Steel (material)

(6) pump 40 (HP), 2000 (yield gpm), Elec. (type power)

(7) electric log no (yes or no)

(organization running log)

(8) how well bottom plugged Plate

JUN 30 1970


DRILLERS REMARKS:

MISS. BD. OF
WATER COMMISSIONERS

6

If well telescopes please sketch and show depths.

GROUND LEVEL

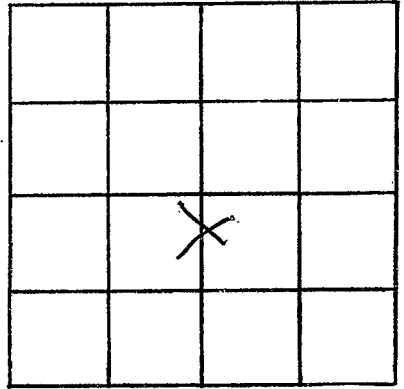

SECTION 6

Please indicate well location X.

ADDITIONAL INFORMATION

If more than one screen, show locations of each on sketch.