

Yazoo
L 19
7-18-70

MISSISSIPPI
BOARD OF WATER COMMISSIONERS
416 North State Street
Jackson, Mississippi 39201

CODED

WATER WELL DRILLERS LOG

July 18 1970 F.M. "Bud" Cresswell Yazoo
date well completed firm name county well located

LANDOWNER:

Mrs. Emma Boles
Rt. 3
Yazoo City, Miss-
(mailing address)

description of formations encountered

from to

Clay 0 35
sand-gravel 35 85

WELL LOCATION:

sec 35 T 11 N R 2
5 miles S of Yazoo City
(distance) (direction) (nearest town)

CODED

WELL PURPOSE: Domestic
(home, irrigation, municipal, industrial)

WELL COMPLETION DATA:

- (1) diameter (inches) 2
- (2) total depth (feet) 85
- (3) static water level (feet) 65 below top of ground.
- (4) casing galv. 80
(material) (depth)
2 (size) If telescope see back.
- (5) screen 5 80
(length) (depth to top)
2 Stainless
(size) (material)
- (6) pump 3/4 5
(HP) (yield gpm)
0 (type power)
- (7) electric log No
(yes or no)
0
(organization running log)

(8) how well bottom plugged

Steel plug


DRILLERS REMARKS:

JUL 21 1970

MISS. BD. OF
WATER COMM.

If well telescopes please sketch and show depths.

GROUND LEVEL

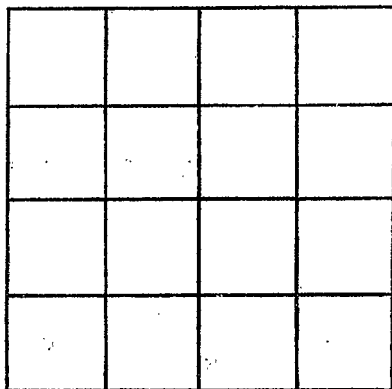

SECTION _____

Please indicate well location X.

ADDITIONAL INFORMATION

If more than one screen,
show locations of each on sketch.