

YAZOO  
L24  
5-2-74

MISSISSIPPI  
 BOARD OF WATER COMMISSIONERS  
 416 North State Street  
 Jackson, Mississippi 39201

**CODED**

**WATER WELL DRILLERS LOG**

May 2 1974 E.M. "Bud" Cresswell Yazoo  
 date well completed firm name county well located

**LANDOWNER:**  
Billy Ketcham  
Yazoo City Miss.  
 (mailing address)

description of formations encountered	from	to
<u>Clay</u>	<u>0</u>	<u>70</u>
<u>Sand - gravel</u>	<u>70</u>	<u>95</u>

**WELL LOCATION:**  
 sec. 29 T. 11 N. R. 20  
6 miles South of Yazoo  
 (distance) (direction) (nearest town)

**WELL PURPOSE:** Home  
 (home, irrigation, municipal, industrial)

- WELL COMPLETION DATA:**
- (1) diameter (inches) 2
  - (2) total depth (feet) 95
  - (3) static water level (feet) 80 below top of ground.
  - (4) casing Steel 90  
 (material) (depth)  
2 if telescope see back.  
 (size)
  - (5) screen 5 90  
 (length) (depth to top)  
2 Stainless  
 (size) (material)
  - (6) pump 1 5  
 (HP) (yield gpm)  
0  
 (type power)
  - (7) electric log No  
 (yes or no)  
0  
 (organization running log)
  - (8) how well bottom plugged Steel plug


**CODED**

**DRILLERS REMARKS:**  
Steel plug

REGISTERED  
 21 1974

If well telescopes please sketch and show depths.

GROUND LEVEL

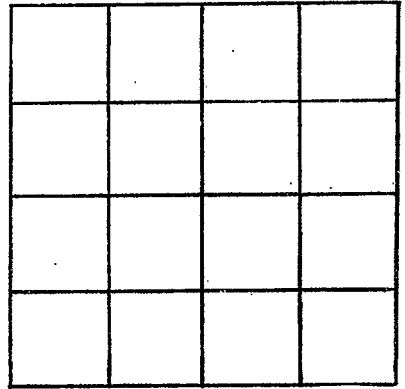

SECTION \_\_\_\_\_

Please indicate well location X.

ADDITIONAL INFORMATION

If more than one screen,  
show locations of each on sketch.