

YAZOO  
L26  
9-24-74  
F. Log # 260

MISSISSIPPI  
BOARD OF WATER COMMISSIONERS  
416 North State Street  
Jackson, Mississippi 39201

CODED

WATER WELL DRILLERS LOG

9-24-74 date well completed      1974 Singer-Lynn Central Div. firm name      Yazoo county well located

LANDOWNER: Yazoo County  
Part Authority  
Yazoo City, Miss  
(mailing address)

description of formations encountered	from	to
Brown Clay	0	30
Blue Clay	30	37
Coarse Sand, lignite clay	37	180
Hard Clay	180	184
Sand & clay	184	250
Clay	250	270
Sandy Clay	270	640
Sh. B. Hard Shale	640	690
Sandy Shale, Sand streak	690	723
Shale & Sand streak	723	780
fine sand	780	795
Shale and Sand streak	795	872
Sand	872	1005
Sand & Shale streak	1005	1030
Shale	1030	1035
Sand & Shale	1035	1095
Sandy Shale	1095	1130

WELL LOCATION:  
sec. 6 T. 11 N. R. 2 E. W.  
(distance) miles (direction) of (nearest town)

WELL PURPOSE:  
(home, irrigation, municipal, industrial)

WELL COMPLETION DATA:

(1) diameter (inches) 18"

(2) total depth (feet) 1003'

(3) static water level (feet) 27' below top of ground.

(4) casing Steel 910' (material) (depth)  
18" If telescope see back. (size) 66' 8 12"  
(5) screen 80' 910' (length) (depth to top)  
12" (size) Stainless Steel (material)


(6) pump 125 1000 (HP) (yield gpm)  
Electric (type power)

(7) electric log yes (yes or no)  
Miss. Geol. Survey (organization running log)

(8) how well bottom plugged valve

DRILLERS REMARKS:  
Pump not installed  
4-11-75

CODED

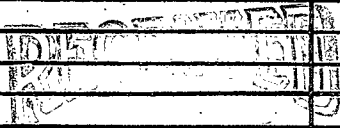

APR 14 1975

②  
If well telescopes please sketch and show depths.

**GROUND LEVEL**


**SECTION**

Please indicate well location X.

**ADDITIONAL INFORMATION**

If more than one screen, show locations of each on sketch.