

MISSISSIPPI DEPARTMENT OF NATURAL RESOURCES

Bureau of Land and Water Resources

Southport Mall

P.O. Box 10631

Jackson, Mississippi 39209

WATER WELL DRILLERS LOG

CODED

YAZOO
L28

June 6 date well completed 86 E.M. Bud Gresswell firm name YAZOO county well located

LANDOWNER:
FOREST PARK, INC.
YAZOO CITY, MS.
(mailing address)

| description of formations encountered | from | to |
|---------------------------------------|-------------|-------------|
| <u>Surface</u> | <u>0</u> | <u>40</u> |
| <u>Sand - gravel</u> | <u>40</u> | <u>60</u> |
| <u>blue - clay</u> | <u>60</u> | <u>260</u> |
| <u>shale</u> | <u>260</u> | <u>460</u> |
| <u>Sand</u> | <u>460</u> | <u>760</u> |
| <u>shale - rock</u> | <u>760</u> | <u>1090</u> |
| <u>Sand</u> | <u>1090</u> | <u>1160</u> |

WELL LOCATION:
sec. 1 T. 11 N. R. 2 E. W. 2
2 miles EAST of YAZOO CITY
(distance) (direction) (nearest town)

WELL PURPOSE: Recreational
(home, irrigation, municipal, industrial)

WELL COMPLETION DATA:

(1) diameter (inches) 4

(2) total depth (feet) 1160

(3) static water level (feet) 260 ~~above~~ below top of ground.

(4) casing Steel 1120
(material) (depth)

4 if telescope see back.
(size)

(5) screen 40 1120
(length) (depth to top)

2 5 inches
(size) (material)

(6) pump 5 2.5
(HP) (yield gpm)


(type power) _____

(7) electric log No
(yes or no)

(organization running log) _____

(8) how well bottom plugged
Back Wash

CODED

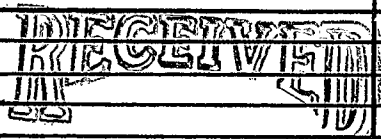


Department of Natural Resources
Bureau of Land and Water Resources

DRILLERS REMARKS:

If well telescopes please
sketch and show depths.

GROUND LEVEL

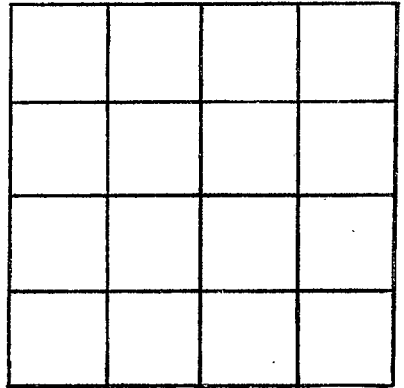

SECTION _____

Please indicate well location X.

ADDITIONAL INFORMATION

If more than one screen,
show locations of each on sketch.