

**MISSISSIPPI
BOARD OF WATER COMMISSIONERS**
416 North State Street
Jackson, Mississippi 39201

WATER WELL DRILLERS LOG

Y2300
L2001
1-66
Elec Log

JAN. 1966 DAVID BERRY YAZOO
date well completed firm name county well located

LANDOWNER:

Taylor & Roberts

YAZOO CITY, MISS.
(mailing address)

WELL LOCATION:

sec 14 T 11 N R 2 E
5 miles SW of YAZOO CITY
(distance) (direction) (nearest town)

WELL PURPOSE: home
(home, irrigation, municipal, industrial)


WELL COMPLETION DATA:

- (1) diameter (inches) 2"
- (2) total depth (feet) 528
- (3) static water level (feet) 250 below above
top of ground.
- (4) casing Galv. 508
(material) (depth)
2"
(size) If telescope see back.
- (5) screen 20 508
(length) (depth to top)
2" Stainless
(size) (material)
- (6) pump 3 HP Compressor
(HP) (yield gpm)
Elec.
(type power)
- (7) electric log Yes
(yes or no)
Miss. Geol. Survey
(organization running log)
- (8) how well bottom plugged 2' plug

description of formations encountered

from to

<u>Top Soil & Clay</u>	<u>0</u>	<u>18</u>
<u>Clay</u>	<u>18</u>	<u>38</u>
<u>SAND & gravel</u>	<u>38</u>	<u>58</u>
<u>gravel</u>	<u>58</u>	<u>58</u>
<u>Clay</u>	<u>58</u>	<u>278</u>
<u>SAND</u>	<u>278</u>	<u>298</u>
<u>SANDY SHALE & SAND Btts</u>	<u>298</u>	<u>338</u>
<u>Shale</u>	<u>338</u>	<u>358</u>
<u>Shale with small Btts Sand</u>	<u>358</u>	<u>378</u>
<u>Shale</u>	<u>378</u>	<u>398</u>
<u>Shale with small layers of sand</u>	<u>398</u>	<u>418</u>
<u>Shale</u>	<u>418</u>	<u>480</u>
<u>Rock</u>	<u>480</u>	<u>480.6</u>
<u>SAND SHALE</u>	<u>480.6</u>	<u>498</u>
<u>SAND</u>	<u>498</u>	<u>528</u>

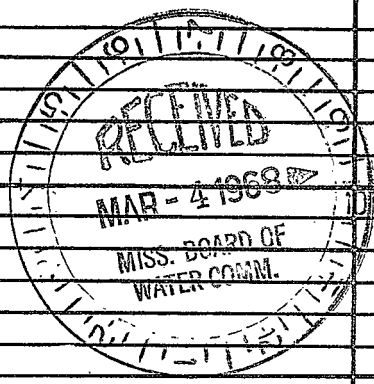


DRILLERS REMARKS:

If well telescopes please sketch and show depths.

GROUND LEVEL

NE, N E S W

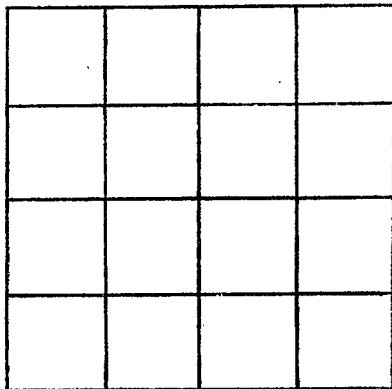

SECTION _____

Please indicate well location X.

ADDITIONAL INFORMATION

If more than one screen,
show locations of each on sketch.