

**MISSISSIPPI
BOARD OF WATER COMMISSIONERS**
416 North State Street
Jackson, Mississippi 39201

WATER WELL DRILLERS LOG

Feb. 15 1967 Bus Crumwell Yazoo
 date well completed firm name county well located

LANDOWNER:

J. D. Twiner

description of formations encountered

	from	to
<u>Surface material</u>	<u>0</u>	<u>60</u>
<u>Yazoo Clay</u>	<u>60</u>	<u>300</u>
<u>sandy shale</u>	<u>300</u>	<u>400</u>
<u>sand</u>	<u>400</u>	<u>480</u>

Yazoo City, Miss-
(mailing address)

WELL LOCATION:


sec. 17 T. 11 N. R. 2 E
4 miles South of Yazoo City
 (distance) (direction) (nearest town)

WELL PURPOSE: Home
 (home, irrigation, municipal, industrial)

WELL COMPLETION DATA:

- (1) diameter (inches) 2"
- (2) total depth (feet) 480
- (3) static water level (feet) 120 ^{below}/_{above} top of ground.
- (4) casing galv. 460'
 (material) (depth)
2" if telescope see back.
 (size)
- (5) screen 20' 460'
 (length) (depth to top)
.008 5.5
 (size) (material)
- (6) pump _____ (HP) _____ (yield gpm)
Air compressor
 (type power)
- (7) electric log NO
 (yes or no)


 (organization running log)
- (8) how well bottom plugged red wax

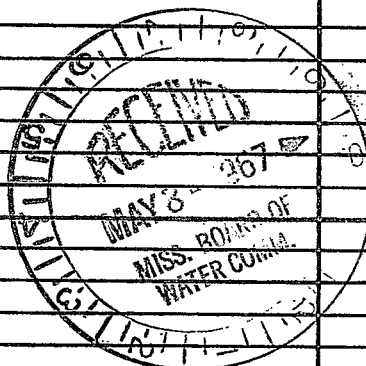

DRILLERS REMARKS:

If well telescopes please sketch and show depths.

GROUND LEVEL

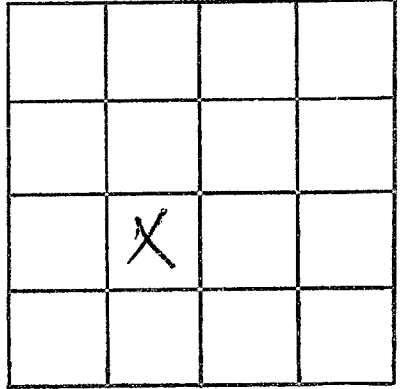

SECTION 17

Please indicate well location X.

ADDITIONAL INFORMATION

If more than one screen, show locations of each on sketch.