

Y200
L 2003
6-67

MISSISSIPPI
BOARD OF WATER COMMISSIONERS
416 North State Street
Jackson, Mississippi 39201

WATER WELL DRILLERS LOG

June 1967 Bud Russell Y200
date well completed firm name county well located

LANDOWNER:

Noel Guthrie
Y200 City, Miss
(mailing address)

WELL LOCATION:

sec. 35 T 11 N R 2 E
6 miles South of Y200
(distance) (direction) (nearest town)


WELL PURPOSE: Home
(home, irrigation, municipal, industrial)

WELL COMPLETION DATA:

- (1) diameter (inches) 4 x 2
- (2) total depth (feet) 1240
- (3) static water level (feet) 260 below above top of ground.
- (4) casing pipe 400' (material) (depth)
4" (size) if telescope see back.
- (5) screen 30' (length) (depth to top)
2" (size) (material)
- (6) pump (HP) (yield gpm)
(type power)
- (7) electric log (yes or no)
(organization running log)
- (8) how well bottom plugged

description of formations encountered


description of formations encountered	from	to
clay	0	40
sand - gravel	40	120
yellow clay	120	380
shell	380	620
sand	620	780
slty shale	780	1000
shale	1000	1120
sand	1120	1150
shaly	1150	1180
sand	1180	1240

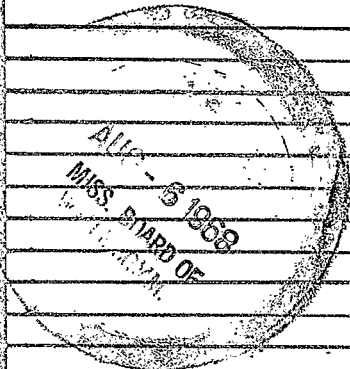

DRILLERS REMARKS:

If well telescopes please sketch and show depths.

GROUND LEVEL

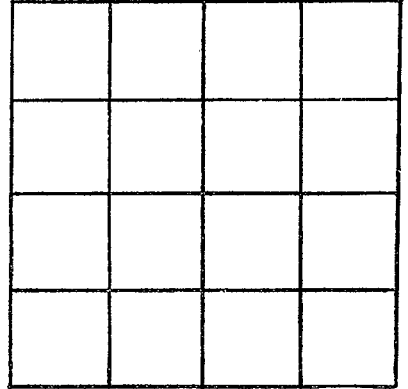

SECTION _____

Please indicate well location X.

ADDITIONAL INFORMATION

If more than one screen, show locations of each on sketch.