

YA200  
 L 2004  
 3-68  
 MISS. Geo Surv  
 3-5

MISSISSIPPI  
 BOARD OF WATER COMMISSIONERS  
 416 North State Street  
 Jackson, Mississippi 39201

WATER WELL DRILLERS LOG

date well completed 1968 firm name Bud Creswell county well located Yazoo

LANDOWNER:  
Mrs. A. D. Payne  
Yazoo City, Mississippi  
 (mailing address)


description of formations encountered	from	to
<u>0 Clay</u>	<u>0</u>	<u>40</u>
<u>Sand - gravel</u>	<u>40</u>	<u>120</u>
<u>Yazoo Clay</u>	<u>120</u>	<u>380</u>
<u>Shale</u>	<u>380</u>	<u>600</u>
<u>Sand</u>	<u>600</u>	<u>640</u>

WELL LOCATION:  
 sec 35 T. 11 N R. 2 E  
6 miles South of Yazoo  
 (distance) (direction) (nearest town)

WELL PURPOSE: home  
 (home, irrigation, municipal, industrial)


WELL COMPLETION DATA:  
 (1) diameter (inches) 2  
 (2) total depth (feet) 640  
 (3) static water level (feet) 200 below above top of ground.  
 (4) casing 2" 620  
 (material) (depth)  
2" if telescope see back.  
 (size)  
 (5) screen 20' 620  
 (length) (depth to top)  
.008, stainless  
 (size) (material)  
 (6) pump air compressor  
 (HP) (yield gpm)  
 (type power)  
 (7) electric log yes  
 (yes or no)  
Miss. State  
 (organization running log)  
 (8) how well bottom plugged

DRILLERS REMARKS:

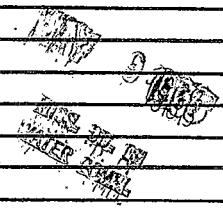

If well telescopes please sketch and show depths.

GROUND LEVEL

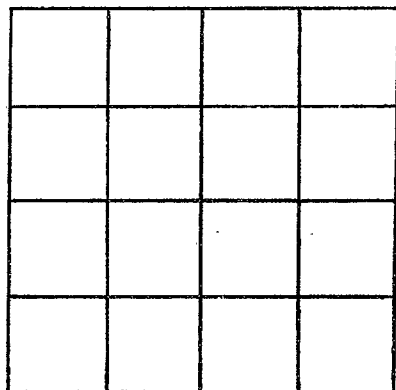

SECTION \_\_\_\_\_

Please indicate well location X.

ADDITIONAL INFORMATION

If more than one screen,  
show locations of each on sketch.