

Yazoo
L-2005
7-68

MISSISSIPPI
BOARD OF WATER COMMISSIONERS
416 North State Street
Jackson, Mississippi 39201

WATER WELL DRILLERS LOG

July 25 1968 MR CONNELL Yazoo
date well completed firm name county well located

LANDOWNER: Harmon Stanley

description of formations encountered	from	to
clay	0	90
clay Gravel	90	95
Blue Clay	98	495
sand with shale streaks,	495	603

(mailing address)

WELL LOCATION:


sec 7 T 11 N R 2 E
S W
2 miles 5 of Yazoo
(distance) (direction) (nearest town)

WELL PURPOSE:
(home, irrigation, municipal, industrial)

WELL COMPLETION DATA:

- (1) diameter (inches) 2
- (2) total depth (feet) 603
- (3) static water level (feet) 225 below top of ground.
- (4) casing steel, 588
(material) (depth)
2" If telescope see back.
(size)
- (5) screen 15', 588
(length) (depth to top)
1", 5. steel
(size) (material)
- (6) pump 2 3
(HP) (yield gpm)
Elec
(type power)
- (7) electric log NO
(yes or no)


(organization running log)
- (8) how well bottom plugged back wash valve.

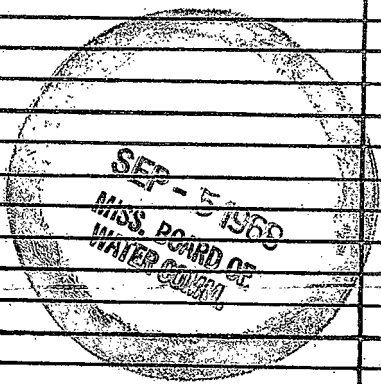

DRILLERS REMARKS:

If well telescopes please
sketch and show depths.

GROUND LEVEL

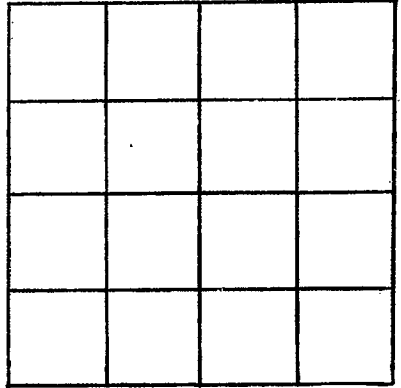

SECTION _____

Please indicate well location X.

ADDITIONAL INFORMATION

If more than one screen,
show locations of each on sketch.