

**MISSISSIPPI
BOARD OF WATER COMMISSIONERS**
416 North State Street
Jackson, Mississippi 39201

710200
12 2000
5-7-75

155

WATER WELL DRILLERS LOG

5-7-
date well completed

Seacoast Drilling Co.
firm name

Yazoo
county well located

LANDOWNER: Cecil Adcock

description of formations encountered

from

to

Yazoo City Miss
RT 5
(mailing address)

Clay
Sand

0 40
40 81
7.0

WELL LOCATION:

sec. 31 T. 11 N. R. 2 W.
7 miles South of Yazoo City
(distance) (direction) (nearest town)

WELL PURPOSE: home
(home, irrigation, municipal, industrial)

WELL COMPLETION DATA:

- (1) diameter (inches) 2"
- (2) total depth (feet) 81
- (3) static water level (feet) 38 below top of ground.
- (4) casing PVC 81
(material) (depth)
(size) if telescope see back.
- (5) screen 6 75
(length) (depth to top)
2" PVC
(size) (material)
- (6) pump 3/4 8
(HP) (yield gpm)
AC
(type power)
- (7) electric log no
(yes or no)

(organization running log)


(8) how well bottom plugged back wash valve

DRILLERS REMARKS:

REGISTERED
MAR 25 1976
MISS. BU. OF WATER

If well telescopes please
sketch and show depths.

GROUND LEVEL

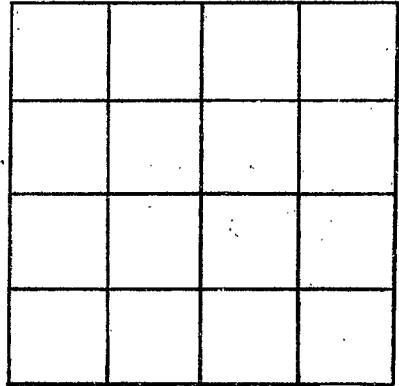

SECTION _____

Please indicate well location X.

ADDITIONAL INFORMATION

If more than one screen,
show locations of each on sketch.