

YAZOO
L 2007
3/16/78

MISSISSIPPI
BOARD OF WATER COMMISSIONERS
416 North State Street
Jackson, Mississippi 39201

WATER WELL DRILLERS LOG

3-16 1978 E.M. "Bud" Cresswell Yazoo
date well completed firm name county well located

LANDOWNER:
H.S. Grey
Yazoo City, MS.
(mailing address)

description of formations encountered	from	to
Clay	0	40
Coast-gravel	40	120
Clay	120	320
Red shale	320	380
sand	380	450

WELL LOCATION:
sec. 31 T. 11 N R. 26 E
3 miles North of Anslay
(distance) (direction) (nearest town)


WELL PURPOSE: Farm
(home, irrigation, municipal, industrial)

- WELL COMPLETION DATA:
- (1) diameter (inches) 4
 - (2) total depth (feet) 450
 - (3) static water level (feet) 225 below top of ground
 - (4) casing PVC 440
(material) (depth)
 - 4 (size) if telescope see back.
 - (5) screen 10 440
(length) (depth to top)
 - 4 PVC
(size) (material)
 - (6) pump 1 1/2 15
(HP) (yield gpm)
 - (type power)
 - (7) electric log No
(yes or no)

(organization running log)

(8) how well bottom plugged
Steel plugs


DRILLERS REMARKS:

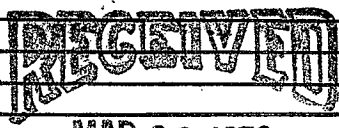

MAR 22 1978

If well telescopes please sketch and show depths.

GROUND LEVEL

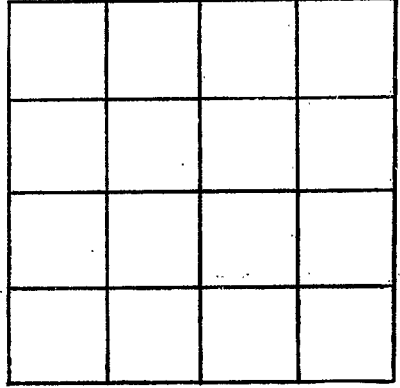

SECTION _____

Please indicate well location X.

ADDITIONAL INFORMATION

If more than one screen, show locations of each on sketch.