

YAZOO
L 2009

MISSISSIPPI
BOARD OF WATER COMMISSIONERS
416 North State Street
Jackson, Mississippi 39201

WATER WELL DRILLERS LOG

7-10 1978 E.M. "Bud" Cresswell YAZOO
date well completed firm name county well located

LANDOWNER:
Mrs. Louise Brooks
Yazoo City, Ms.
(mailing address)

| description of formations encountered | from | to |
|---------------------------------------|-----------|------------|
| <u>Clay</u> | <u>0</u> | <u>70</u> |
| <u>Sand & gravel</u> | <u>70</u> | <u>100</u> |

WELL LOCATION:
sec. 31 T 11 N R. 2 E
W
7 miles South of Yazoo City
(distance) (direction) (nearest town)

WELL PURPOSE: Home
(home, irrigation, municipal, industrial)

WELL COMPLETION DATA:

(1) diameter (inches) 2

(2) total depth (feet) 100

(3) static water level (feet) 80 below above top of ground.

(4) casing PVC 95
(material) (depth)
2 if telescope see back.
(size)

(5) screen 5 95
(length) (depth to top)
2 PVC
(size) (material)

(6) pump 1 5
(HP) (yield gpm)
0
(type power)

(7) electric log No
(yes or no)
0
(organization running log)

(8) how well bottom plugged
Steel Plug


RECEIVED
JUL 19 1978

MISS. BD. OF WATER COMMISSIONERS

DRILLERS REMARKS:

If well telescopes please sketch and show depths.

GROUND LEVEL

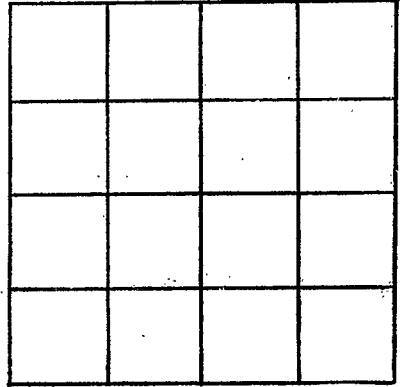

SECTION _____

Please indicate well location X.

ADDITIONAL INFORMATION

If more than one screen, show locations of each on sketch.