

YAZOO
L 2010

MISSISSIPPI
BOARD OF WATER COMMISSIONERS
416 North State Street
Jackson, Mississippi 39201

WATER WELL DRILLERS LOG

7-3 1978 E.M. "Bud" CRESSWELL YAZOO
date well completed firm name county well located

LANDOWNER:
Carlton Restow
Yazoo City, MS.
(mailing address)

description of formations encountered	from	to
	clay sand-gravel	0
	65	90

WELL LOCATION:
sec 35 T 11 N R 2 E
6 miles South of Yazoo City
(distance) (direction) (nearest town)

WELL PURPOSE: home
(home, irrigation, municipal, industrial)

WELL COMPLETION DATA:

(1) diameter (inches) 4

(2) total depth (feet) 90

(3) static water level (feet) 70 below top of ground.

(4) casing PVC 80
(material) (depth)
4 (size) If telescope see back.

(5) screen 10 80
(length) (depth to top)
4 PVC
(size) (material)

(6) pump 1 20
(HP) (yield gpm)
0 (type power)

(7) electric log no
(yes or no)

(organization running log)

(8) how well bottom plugged
Steel plug


DRILLERS REMARKS:

RECEIVED
JUL 19 1978

MISS. BD. OF WATER COMMISSIONERS

If well telescopes please sketch and show depths.

GROUND LEVEL

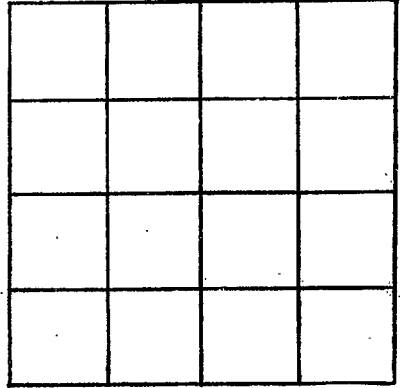

SECTION _____

Please indicate well location X.

ADDITIONAL INFORMATION

If more than one screen, show locations of each on sketch.