

Yazoo
L
2012

MISSISSIPPI
BOARD OF WATER COMMISSIONERS
416 North State Street
Jackson, Mississippi 39201

WATER WELL DRILLERS LOG

Oct. 27 1982 E.M. "Bud" CRESSWELL Yazoo
date well completed firm name county well located

LANDOWNER:
Sweeney Plunkett
Yazoo City, Mo. 39194
(mailing address)

description of formations encountered	from to	
	feet	feet
Clay	0	60
sand-gravel	60	105

WELL LOCATION:
sec. 1 T 14 N R 2 W
6 miles South of Yazoo City
(distance) (direction) (nearest town)

WELL PURPOSE: Home
(home, irrigation, municipal, industrial)

WELL COMPLETION DATA:

(1) diameter (inches) 2

(2) total depth (feet) 105

(3) static water level (feet) 80 below above top of ground.

(4) casing Steel, 100 (material) (depth)
2 (size) if telescope see back.

(5) screen 5, 100 (length) (depth to top)
2, Stainless (size) (material)

(6) pump 1, 5 (HP) (yield gpm)
(type power)

(7) electric log NO (yes or no)
(organization running log)

(8) How well bottom plugged
each well valve

DRILLERS REMARKS:


DEPT. OF NATURAL RESOURCES
BUREAU OF LAND & WATER RESOURCES

NOV 22 1982

RECEIVED

If well telescopes please sketch and show depths.

GROUND LEVEL

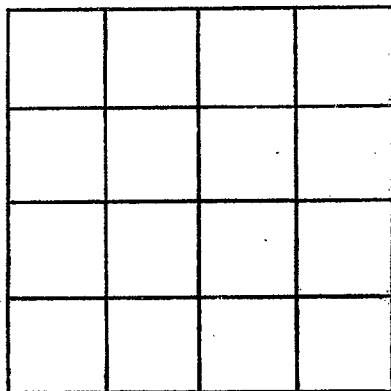

SECTION _____

Please indicate well location X.

ADDITIONAL INFORMATION

If more than one screen, show locations of each on sketch.