

YA200
M
10-61

MISSISSIPPI BOARD OF WATER COMMISSIONERS

WATER WELL DRILLERS LOG

M
3

Date: Oct. , 19 61, Driller: David F. Berry & Son County Yazoo
(Name)

(1) Owner of Land: Williams & Williams
Cedar Grove Plantation
Benton, Miss.
(Address)

(2) Location: 1/4, 1/4, Sec. T. R.
 miles of
(distance) (direction) (Nearest Town)

(3) Topography: Hilly
(Hilly) (Flat) (Level)

(4) Purpose of Well: Personal
(Domestic Irrigation
Municipal, Industrial, Other)

Information upon completion of well:

(1) Diameter 4 inches.

(2) Total Depth 788 feet.

(3) Water Level 151 feet below top of ground.

(4) Cased to 788, Size .


(5) Screen: Size 2", Length 40'.

(6) Were any formations sealed against pollution?
 yes, no.

If YES depth of formation

Why

Drillers Remarks:

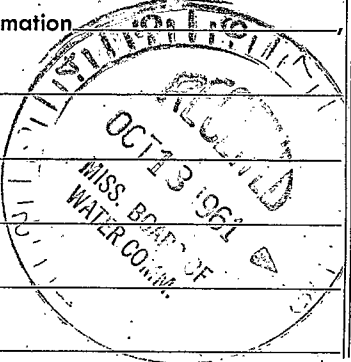

Description & Color of Materials Sand, Clay, Red Clay, Shell, etc.	Thick- ness Feet	Depth Feet
Kelly		21
clay	20	41
clay	20	61
clay	20	81
clay & 5' sand	20	101
sand	20	121
sand	20	141
clay	20	161
clay	20	181
sand	20	201
sand	20	221
sand	20	241
sand	20	261
sand (run out of sand)	20	281
clay	20	301
top of sand	20	321
sand	20	341
sand	20	361
sand	20	381
sand	20	401
sand	20	421
sand	20	441
sand	20	461
sand	20	481
sand	20	501
sand	20	521
sand	20	541
sand	20	561
sand run out of sand	20	581
Hard clay	20	601
Hard clay	20	621
Hard clay	20	641
15' of clay 5' of sand	20	681
12" rock Hard clay	20	701
Hard clay	20	721
sand	20	741
sand good sand (Use Back Side)	20	761

sand	20	781
sand	5	786
sand	2	788

20' of screen No. .008
 20' of screen No. .0010
 168' of 2" pipe
 201' of 3" pipe
 417' of 4" pipe
 3 X2 lead seal L & R
 2" Tail pipe 14' long
 2 X1 Plug 2½' long
 4 X3 Swedge Nipple
 199' of 2" drop pipe