

YAZOO
M 13
5-2-62

MISSISSIPPI BOARD OF WATER COMMISSIONERS

WATER WELL DRILLERS LOG

C1264

Date: May 2, 1962, Driller: Layne-Central Company County Yazoo

(Name)

CODED

Board of Education of
(1) Owner of Land: Yazoo County
(Name)
Benton School
Benton, Mississippi
(Address)

(2) Location: 1/4, 1/4, Sec. 12 T11W R1W
_____ miles _____ of _____
(distance) (direction) (Nearest Town)

(3) Topography: flat
(Hilly) (Flat) (Level)

(4) Purpose of Well: domestic
(Domestic Irrigation
Municipal, Industrial, Other)

Description & Color of Materials Sand, Clay, Red Clay, Shell, etc.	Thick- ness Feet	Depth Feet
Clay	41	41
Sand & gravel	21	62
Clue clay	119	181
Sand rock	2	183
Sandy clay	18	201
Fine sand, strks. of shale	64	265
Clay	13	278
Sand & clay strks.	12	290
Sand rock	1	291
Fine sand & clay strks.	10	301
Sandy shale & hard strks.		
of shale	54	355
Sand rock	1	356
Sandy shale & clay	18	374
Rock	2	376
Sand & shale with hard		
strks. CODED	214	590
Sand CODED	25	615
Hard shale, strks. of		
sand	70	685
Sand & shale	35	720
Shale streaks of sand	65	785
Sand rock, strks. of sha		
shale	4	789
Sandy shale	75	864
Hard shale, strks. of		
sand	94	958
Fine sand, strks. of		
sand	28	986
Fine sand, few strks. of		
shale	206	1192

Information upon completion of well:

(1) Diameter 6" x 4" x 2 1/2" inches.

(2) Total Depth 1192 feet.

(3) Water Level 218 feet below top of ground.


(4) Cased to 1123', Size 6" & 4"

(5) Screen: Size 2 1/2", Length 60'

(6) Were any formations sealed against pollution?
yes yes, no no.

If YES depth of formation Cemented for full
length of casing. Mechanical seal
between 4" and blank, 1088'
Why _____

Drillers Remarks: _____

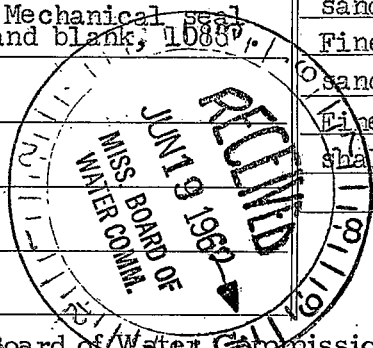

(Use Back Side)

Well No.

