

ELOG #172

Yazoo  
M18  
10-67  
Elec Log

MISSISSIPPI  
BOARD OF WATER COMMISSIONERS CODED  
416 North State Street  
Jackson, Mississippi 39201

WATER WELL DRILLERS LOG

10-27-67 19 Bud Cresswell Yazoo  
date well completed firm name county well located

LANDOWNER:  
Charles Hood  
Benton, Miss.  
(mailing address)


description of formations encountered	from	to
yellow clay	0	40
shale	40	430
sand	430	553

WELL LOCATION:  
sec 24 T. 11 N. R. 1 E. S. 1 W.  
3 miles south of Benton  
(distance) (direction) (nearest town)

WELL PURPOSE: Domestic  
(home, irrigation, municipal, industrial)

WELL COMPLETION DATA:


- (1) diameter (inches) 2
- (2) total depth (feet) 553
- (3) static water level (feet) 80 below top of ground.
- (4) casing metal 533 (material) (depth)
- 2 (size) If telescope see back.
- (5) screen 20 533 (length) (depth to top)
- .008 stainless (size) (material)
- (6) pump air compressor (HP) (yield gpm)
- (type power)
- (7) electric log yes (yes or no)
- U. S. Geological Survey (organization running log)
- (8) how well bottom plugged

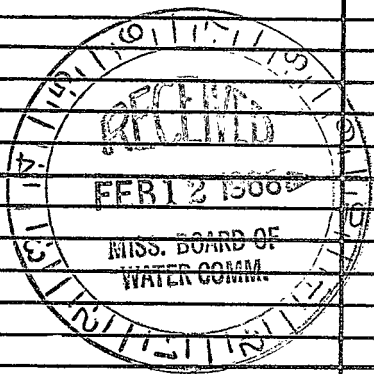

DRILLERS REMARKS:

If well telescopes please sketch and show depths.

GROUND LEVEL

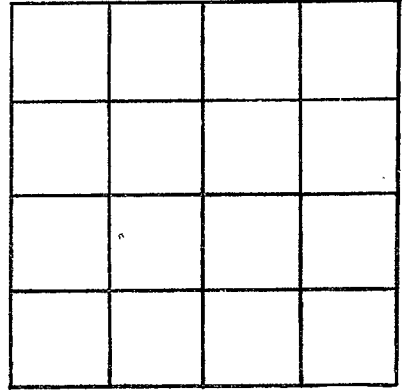

SECTION 24

Please indicate well location X.

ADDITIONAL INFORMATION

If more than one screen, show locations of each on sketch.