

CODED

ELOG #194

CODED

MISSISSIPPI
 BOARD OF WATER COMMISSIONERS
 416 North State Street
 Jackson, Mississippi 39201

WATER WELL DRILLERS LOG

CODED

YAZOO
 M19
 8-29-68
 M.G.S.

8-29-1968 Bud Cresswell Yazoo
 date well completed firm name county well located

LANDOWNER:

M. L. Washington

Yazoo City, Miss.
 (mailing address)

WELL LOCATION:

sec. 33 T11 N R 1 E
 W
 5 miles S.W. of Benton
 (distance) (direction) (nearest town)


WELL PURPOSE: domestic
 (home, irrigation, municipal, industrial)

WELL COMPLETION DATA:

- (1) diameter (inches) 2
- (2) total depth (feet) 1126
- (3) static water level (feet) 205 below above top of ground.
- (4) casing galv. pipe, (material) (depth)
2 1/2 if telescope see back. (size)
- (5) screen 20 Ft. 7 780 (length) (depth to top)
008, stainless (size) (material)
- (6) pump air compressor (HP) (yield gpm)
 (type power)
- (7) electric log yes (yes or no)
Miss. Geo. Survey (organization running log)
- (8) how well bottom plugged _____

description of formations encountered	from	to
clay	0	35
Blue Clay	35	325
shale streaks sand	325	440
shale hard	440	545
sand streaks shale	545	645
shale	645	665
sandy shale	665	755
shale hard	755	775
sand shale streaks	775	885
sandy shale	885	1126


CODED

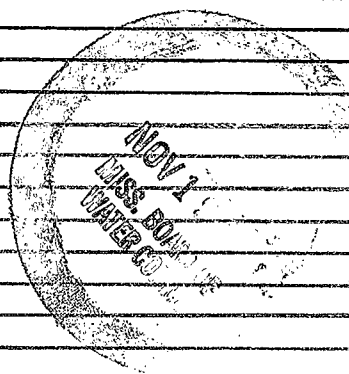

DRILLERS REMARKS:

If well telescopes please sketch and show depths.

GROUND LEVEL

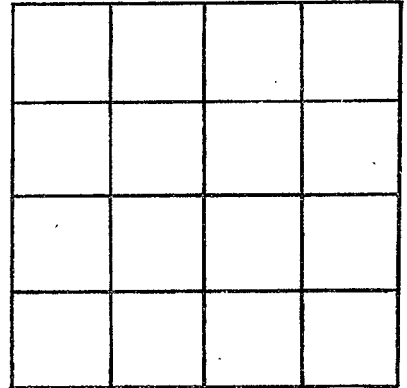

SECTION 33

Please indicate well location X.

ADDITIONAL INFORMATION

If more than one screen, show locations of each on sketch.