

CODED

DEC 18 1968

MISSISSIPPI  
BOARD OF WATER COMMISSIONERS  
416 North State Street  
Jackson, Mississippi 39201

MISS. BD. OF  
WATER COMML

WATER WELL DRILLERS LOG

YR 200
M 20
68

19 David Benny Yazoo  
 date well completed firm name county well located

LANDOWNER: James Moore  
Benton, Miss.

description of formations encountered	from	to
<u>Clay</u>	<u>0</u>	<u>10</u>
<u>sand</u>	<u>10</u>	<u>30</u>

(mailing address)

WELL LOCATION:

sec 28 T N R 1 E  
S W  
 miles \_\_\_\_\_ of \_\_\_\_\_  
 (distance) (direction) (nearest town)

CODED

WELL PURPOSE:

(home, irrigation, municipal, industrial)

WELL COMPLETION DATA:

- (1) diameter (inches) 2"
- (2) total depth (feet) 40
- (3) static water level (feet) 0 below above top of ground.
- (4) casing galv. 35  
 (material) (depth)  
2" if telescope see back.  
 (size)
- (5) screen 5 35  
 (length) (depth to top)  
2"  
 (size) (material)
- (6) pump 1/2 \_\_\_\_\_  
 (HP) (yield gpm)  
elec.  
 (type power)
- (7) electric log no  
 (yes or no)


(organization running log)

(8) how well bottom plugged 1 1/2" plug

DRILLERS REMARKS:

If well telescopes please sketch and show depths.

GROUND LEVEL

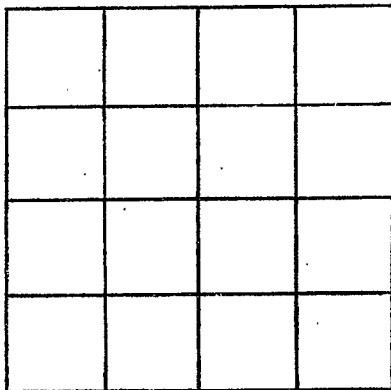

SECTION \_\_\_\_\_

Please indicate well location X.

ADDITIONAL INFORMATION

If more than one screen, show locations of each on sketch.