

DEC 18 1968

MISSISSIPPI  
BOARD OF WATER COMMISSIONERS  
416 North State Street  
Jackson, Mississippi 39201

MISS. BD. OF  
WATER COMMISSIONERS  
CODED

WATER WELL DRILLERS LOG

V200
M21
68

19 Joseph Davis Benny Yesso  
 date well completed firm name county well located

LANDOWNER: Joseph William  
Benton, Miss  
 (mailing address)

description of formations encountered	from	to
Clay & top soil	0	40
sand	40	55
Clay	55	130
sand	130	186

WELL LOCATION:  
 sec 14 T 14 N R 1 E  
5 W  
 (distance) miles \_\_\_\_\_ of \_\_\_\_\_ (direction) (nearest town)

CODED


WELL PURPOSE:  
 (home, irrigation, municipal, industrial)

- WELL COMPLETION DATA:
- (1) diameter (inches) 2"
  - (2) total depth (feet) 186'
  - (3) static water level (feet) 70 below top of ground.
  - (4) casing galv. 181  
 (material) (depth)  
2" if telescope see back.  
 (size)
  - (5) screen 5 181  
 (length) (depth to top)  
1 1/2" stainless  
 (size) (material)
  - (6) pump 3/4 \_\_\_\_\_  
 (HP) (yield gpm)  
etc.  
 (type power)
  - (7) electric log no  
 (yes or no)  
 \_\_\_\_\_  
 (organization running log)
  - (8) how well bottom plugged 5/8"

DRILLERS REMARKS:

If well telescopes please sketch and show depths.

GROUND LEVEL

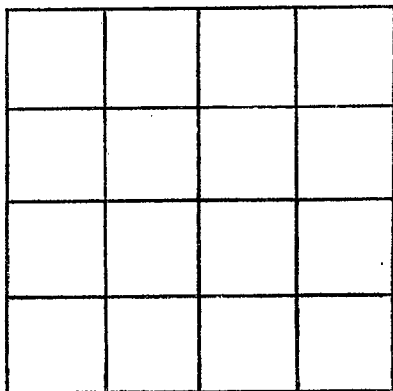

SECTION \_\_\_\_\_

Please indicate well location X.

ADDITIONAL INFORMATION

If more than one screen,  
show locations of each on sketch.