

Yazoo Co
M 24
8-69

MISSISSIPPI
BOARD OF WATER COMMISSIONERS
416 North State Street
Jackson, Mississippi 39201

CODED

WATER WELL DRILLERS LOG

August

1969 John Davis

Yazoo

date well completed

firm name

county well located

LANDOWNER:
Willie Pickett
Scotland Community
(mailing address)

description of formations encountered	from	to
red clay	0	35
Lt. Blue clay	35	45
Blue mud	45	135
Fine sand	135	147
Blue mud	147	187
Fine sand	187	193
Blue mud	193	220
Fine sand	220	300
streaks Blue mud sand	300	370
Good sand	370	410

WELL LOCATION:
sec. 31 T. 11 N. R. 1 E
1/4 miles E of Scotland Forest
(distance) (direction) (nearest town)

WELL PURPOSE: home
(home, irrigation, municipal, industrial)

WELL COMPLETION DATA:

(1) diameter (inches) 2"

(2) total depth (feet) 410

(3) static water level (feet) 60 below above top of ground.

(4) casing Galv 400' (material) (depth)
2" if telescope see back. (size)

(5) screen 10' 400' (length) (depth to top)
2" S.S. (size) (material)

(6) pump 2 15 (HP) (yield gpm)
Elec (type power)

(7) electric log NO (yes or no)

(organization running log)


(8) how well bottom plugged Fin

DRILLERS REMARKS:

SEP 1969
MISS. BD. OF
WATER COMMISSIONERS

If well telescopes please sketch and show depths.

GROUND LEVEL

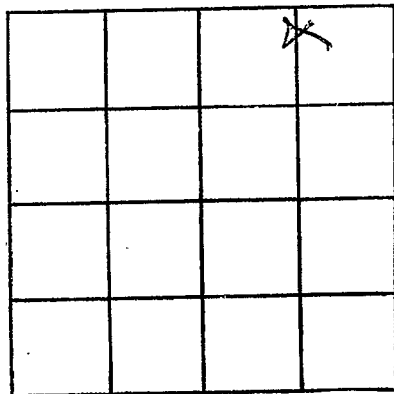

SECTION 33

Please indicate well location X.

ADDITIONAL INFORMATION

If more than one screen,
show locations of each on sketch.