

Yazoo Co  
 M 26  
 2-21-70

MISSISSIPPI  
 BOARD OF WATER COMMISSIONERS  
 416 North State Street  
 Jackson, Mississippi 39201

WATER WELL DRILLERS LOG

2-21 1970 Bud Cresswell Yazoo  
 date well completed firm name county well located

LANDOWNER:

Joe E. MANOR  
 Flora, Miss.  
 (mailing address)

description of formations encountered

from to

Clay  
 Sand gravel 0 20  
 20 47

WELL LOCATION:

sec 29 T 11 N R 1 E 150  
 6 miles SE of Yazoo  
 (distance) (direction) (nearest town)

WELL PURPOSE:

Home  
 (home, irrigation, municipal, industrial)

WELL COMPLETION DATA:

- (1) diameter (inches) 2
- (2) total depth (feet) 47
- (3) static water level (feet) 25 below above top of ground.
- (4) casing galv. 42  
 (material) (depth)  
 2" if telescope see back.  
 (size)
- (5) screen 5' 42  
 (length) (depth to top)  
 2" Stainless  
 (size) (material)
- (6) pump (HP) (yield gpm)  
 (type power)
- (7) electric log (yes or no)  
 (organization running log)
- (8) how well bottom plugged


APR 24 1970

MISS. BD. OF  
 WATER COMM.

DRILLERS REMARKS:

If well telescopes please sketch and show depths.

GROUND LEVEL

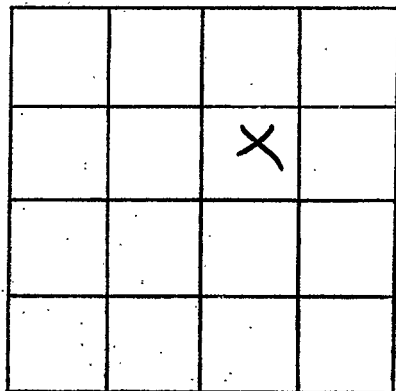

SECTION \_\_\_\_\_

Please indicate well location X.

ADDITIONAL INFORMATION

If more than one screen,  
show locations of each on sketch.