

Yazoo Co  
 M 27  
 2-22-70

MISSISSIPPI  
 BOARD OF WATER COMMISSIONERS  
 416 North State Street  
 Jackson, Mississippi 39201

WATER WELL DRILLERS LOG

Feb. 22 1970 Bud Cresswell Yazoo  
 date well completed firm name county well located

LANDOWNER:  
 Hugh F. Manor  
 Yazoo City, Miss-  
 (mailing address)

description of formations encountered	from	to
	Clay	0
Sand gravel	60	110

WELL LOCATION:  
 sec. 20 T. 110 N. R. 1 E. 150  
 6 miles S.E. of Yazoo  
 (distance) (direction) (nearest town)

WELL PURPOSE: Domestic  
 (home, irrigation, municipal, industrial)

WELL COMPLETION DATA:

(1) diameter (inches) 2

(2) total depth (feet) 110

(3) static water level (feet) 80 below top of ground.

(4) casing 9410, 105, 2" if telescope see back.  
 (material) (depth) (size)

(5) screen 5, 105, 2" stainless  
 (length) (depth to top) (size) (material)

(6) pump (HP) (yield gpm)  
 (type power)

(7) electric log (yes or no)  
 (organization running log)

(8) how well bottom plugged


APR 24 1970

MISS. BD. OF WATER COMM.

DRILLERS REMARKS:

If well telescopes please sketch and show depths.

GROUND LEVEL

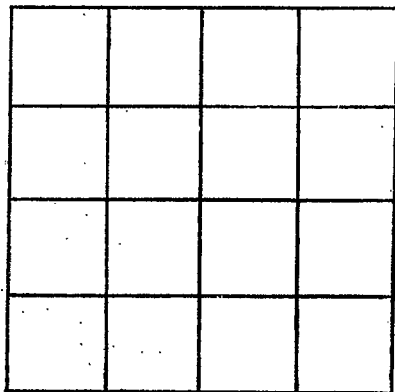

SECTION \_\_\_\_\_

Please indicate well location X.

ADDITIONAL INFORMATION

If more than one screen, show locations of each on sketch.