

MISSISSIPPI
BOARD OF WATER COMMISSIONERS
416 North State Street
Jackson, Mississippi 39201

CODED

WATER WELL DRILLERS LOG

YAZOO
M28
8-20-70

Aug. 20, 1970 ^{E.M.M.} Bud Gerswell Yazoo
date well completed firm name county well located
WATER WELL DRILLING

LANDOWNER:

description of formations encountered

from to

Lanfers Manor
Lenton, Miss-
(mailing address)

Clay
Sand Gravel

0 12
12 35

WELL LOCATION:

sec. 33 T 11 N R 1
6 miles SW of Lenton
(distance) (direction) (nearest town)

WELL PURPOSE: Domestic
(home, irrigation, municipal, industrial)

WELL COMPLETION DATA:

- (1) diameter (inches) 2
- (2) total depth (feet) 35
- (3) static water level (feet) 4 below ~~above~~ top of ground.
- (4) casing galv. (material), 30 (depth),
2 (size) if telescope see back.
- (5) screen 5 (length), 30 (depth to top),
2" (size), stainless (material)
- (6) pump 0 (HP), 5 (yield gpm),
0 (type power)
- (7) electric log no (yes or no),
0 (organization running log)

CODED

SEP 15 1970

(8) how well bottom plugged


Steel Plug

MISS. BD. OF
WATER COMM.

DRILLERS REMARKS:

If well telescopes please sketch and show depths.

GROUND LEVEL

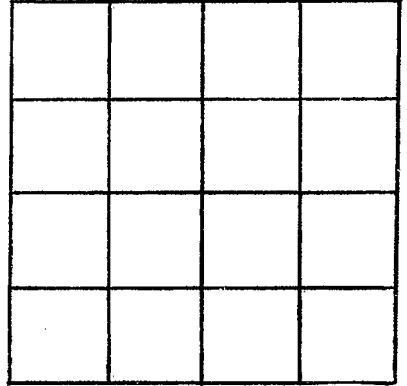

SECTION _____

Please indicate well location X.

ADDITIONAL INFORMATION

If more than one screen,
show locations of each on sketch.