

YAZOO
M29
10-29-70

MISSISSIPPI
BOARD OF WATER COMMISSIONERS
416 North State Street
Jackson, Mississippi 39201

CODED

WATER WELL DRILLERS LOG

October 29 1970 E.M. "Bud" Cresswell Yazoo
date well completed firm name county well located

LANDOWNER:	description of formations encountered	from	to
Hugh M. Bond Yazoo City, Miss. (mailing address)			
WELL LOCATION:			
sec. 18 T 11 N R 1 E 5 miles SE of Yazoo (distance) (direction) (nearest town)			
WELL PURPOSE: Home (home, irrigation, municipal, industrial)			
WELL COMPLETION DATA:			
(1) diameter (inches) 2			
(2) total depth (feet) 110			
(3) static water level (feet) 80 below top of ground.			
(4) casing 2" galv. (material) 10.5 (depth)			
(5) screen 2" (size) 5 ft. (length) 10.5 ft. (depth to top)			
(6) pump 3/4 (HP) 5 (yield gpm)			
(7) electric log NO (yes or no)			
(8) how well bottom plugged NO			
DRILLERS REMARKS: Steel plug			


CODED

NOV 23 1970

MISS. BD. OF
WATER

If well telescopes please
sketch and show depths.

GROUND LEVEL

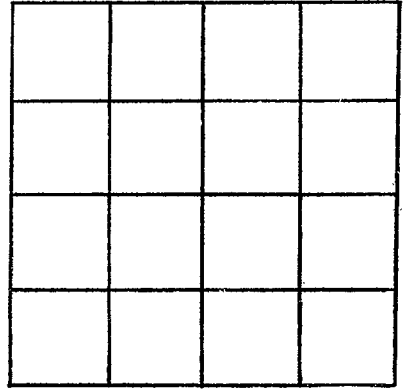

SECTION _____

Please indicate well location X.

ADDITIONAL INFORMATION

If more than one screen,
show locations of each on sketch.