

YA200
M33
5-63

MISSISSIPPI BOARD OF WATER COMMISSIONERS

WATER WELL DRILLERS LOG

CODED

Date: May, 1963, Driller: David Benny County Yazoo
~~W.H. Jones~~
(Name)

5544 5590 6328

(1) Owner of Land: W.H. Jones
(Name)
Benton, Miss
(Address) 31 11 26
21 11 1W
(2) Location: 1/4, 1/4, Sec. 21 12 R 16
_____ miles _____, of BENTON,
(distance) (direction) (Nearest Town)
(3) Topography: Hilly Level
(Hilly) (Flat) (Level)
(4) Purpose of Well: Domestic
(Domestic Irrigation
Municipal, Industrial, Other)


Description & Color of Materials Sand, Clay, Red Clay, Shell, etc.	Thick- ness Feet	Depth Feet
<u>clay</u>		<u>34</u>
<u>Sandy clay</u>	<u>20</u>	<u>54</u>
<u>Coars. sand</u>	<u>16</u>	<u>70</u>
<u>clay</u>	<u>10</u>	<u>80</u>

Information upon completion of well:

(1) Diameter 2 inches.
(2) Total Depth 80 feet.
(3) Water Level _____ feet below top of ground.
(4) Cased to _____, Size _____
(5) Screen: Size #2", Length 10'
(6) Were any formations sealed against pollution?
_____ yes, _____ no.

CODED

If YES depth of formation _____
Why _____
Drillers Remarks: _____

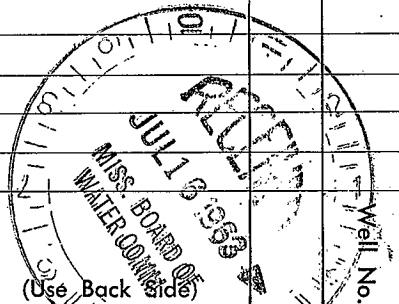

1912

1.
2.
3.
4.
5.

1913

1.
2.
3.
4.
5.

1914

1.
2.
3.
4.
5.