

YAZOO
M 34
4-10-72

MISSISSIPPI
 BOARD OF WATER COMMISSIONERS
 416 North State Street
 Jackson, Mississippi 39201

WATER WELL DRILLERS LOG

April 10 19 72 Jeffcoat Drilling Co Yazoo
 date well completed firm name county well located


LANDOWNER: <u>Hilton Brown</u>	description of formations encountered	from	to
<u>Benton Miss. Rfd</u>			
	<u>M.B. sand</u>	<u>108</u>	<u>130</u>
	<u>clay</u>	<u>130</u>	<u>249</u>
(mailing address)	<u>Sand fine</u>	<u>249</u>	<u>310</u>
WELL LOCATION:	<u>fine sand with clay brk</u>	<u>310</u>	<u>401</u>
sec. <u>15</u> T. <u>11</u> N. R. <u>1</u> E	<u>sand fine</u>	<u>401</u>	<u>462</u>
<u>6</u> miles S/W of <u>Benton</u>			
(distance) (direction) (nearest town)			
WELL PURPOSE: <u>Home</u>			
(home, irrigation, municipal, industrial)			
WELL COMPLETION DATA:			
(1) diameter (inches) <u>2"</u>			
(2) total depth (feet) <u>452</u>			
(3) static water level (feet) <u>116</u> below top of ground.			
(4) casing <u>2.5 galv 445</u>			
(material) (depth)			
(size) if telescope see back.			
(5) screen <u>6 ft 445</u>			
(length) (depth to top)			
m <u>2"</u> Galv.			
(size) (material)			
(6) pump <u>3/4 hp 44</u>			
(HP) (yield gpm)			
<u>AC</u>			
(type power)			
(7) electric log <u>No</u>			
(yes or no)			
(organization running log)			
(8) how well bottom plugged <u>1 1/8 Steel Rod</u>			
DRILLERS REMARKS:			
<u>All very fine takes</u>			
<u>no.006. screen to hold</u>			
<u>sand</u>			

JUN 3 1972

MISS. BU. OF WATER COMMISSIONERS

If well telescopes please
sketch and show depths.

GROUND LEVEL

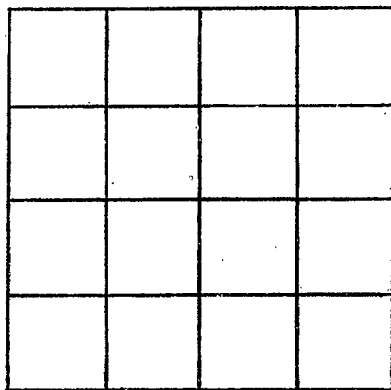

SECTION _____

Please indicate well location X.

ADDITIONAL INFORMATION

If more than one screen,
show locations of each on sketch.