

YAZOO
M35
8-8-72

MISSISSIPPI
BOARD OF WATER COMMISSIONERS
416 North State Street
Jackson, Mississippi 39201

CODED

WATER WELL DRILLERS LOG

Aug. 8 1972 E.M. "Bud" Cresswell Yazoo
date well completed firm name county well located


LANDOWNER:	description of formations encountered	from	to
Mrs. Janie Appenehite Benton, Miss. (mailing address)	Clay sand-gravel	0 15	15 47
WELL LOCATION: sec. <u>29</u> T. <u>11</u> N R. <u>1</u> W <u>6</u> miles <u>SE</u> of <u>YAZOO</u> (distance) (direction) (nearest town)			
WELL PURPOSE: <u>Dr. mesled</u> (home, irrigation, municipal, industrial)			
WELL COMPLETION DATA:			
(1) diameter (inches) <u>2</u>			
(2) total depth (feet) <u>47</u>			
(3) static water level (feet) <u>25</u> below top of ground. above			
(4) casing <u>Steel</u> , <u>42</u> , (material) (depth) <u>2</u> (size) if telescope see back.			
(5) screen <u>5</u> , <u>42</u> (length) (depth to top)			
<u>2</u> , <u>Stainless</u> (size) (material)			
(6) pump <u>3/4</u> , <u>10</u> (HP) (yield gpm)			
<u>0</u> (type power)			
(7) electric log <u>0</u> (yes or no)			
<u>0</u> (organization running log)			
(8) how well bottom plugged <u>Steel plug</u>			
DRILLERS REMARKS:			

CODED

REC'D
SEPT 17 1972
MISS. BU.
STATE WATER COM.

If well telescopes please
sketch and show depths.

GROUND LEVEL

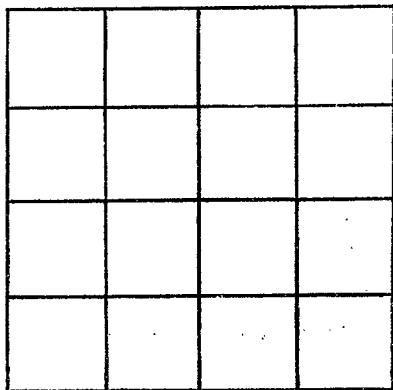

SECTION _____

Please indicate well location X.

ADDITIONAL INFORMATION

If more than one screen,
show locations of each on sketch.