

ELOG # 173

MISSISSIPPI
BOARD OF WATER COMMISSIONERS
416 North State Street
Jackson, Mississippi 39201


CODED

WATER WELL DRILLERS LOG

Yazoo
N 20
11-67
Elcc Log


11-7-67 19 Bud Cresswell Yazoo
date well completed firm name county well located

LANDOWNER:	description of formations encountered	from	to
Phillip Dixon Benton, Mississippi (mailing address)			
WELL LOCATION:			
sec. <u>22</u> T. <u>11</u> N. R. <u>1</u> E XXX XWX <u>5</u> miles <u>East</u> of <u>Benton</u> (distance) (direction) (nearest town)			
WELL PURPOSE: <u>Domestic</u> (home, irrigation, municipal, industrial)			
WELL COMPLETION DATA:			
(1) diameter (inches) <u>2</u>			
(2) total depth (feet) <u>441</u>			
(3) static water level (feet) <u>85</u> below top of ground.			
(4) casing <u>steel</u> <u>421</u> (material) (depth)			
<u>2</u> (size) if telescope see back.			
(5) screen <u>20</u> , <u>421</u> (length) (depth to top)			
<u>.008</u> , <u>stainless</u> (size) (material)			
(6) pump <u>air</u> <u>compressor</u> (HP) (yield gpm)			
(type power)			
(7) electric log <u>yes</u> (yes or no)			
<u>Miss. State</u> (organization running log)			
(8) how well bottom plugged			
DRILLERS REMARKS:			

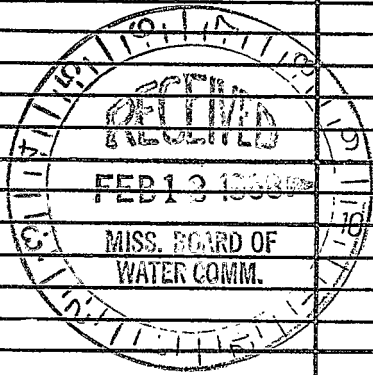

If well telescopes please sketch and show depths.

GROUND LEVEL

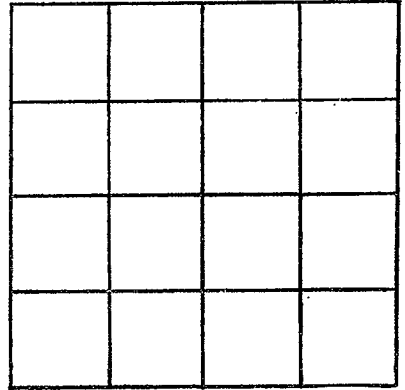

SECTION 22

Please indicate well location X.

ADDITIONAL INFORMATION

If more than one screen,
show locations of each on sketch.