

CODED

MISSISSIPPI
BOARD OF WATER COMMISSIONERS
416 North State Street
Jackson, Mississippi 39201

CODED

WATER WELL DRILLERS LOG

YAZOO
N22
12-3-68

12/3 1968 John A. Davis Yazoo
date well completed firm name county well located

LANDOWNER: Sam E. Dixon

description of formations encountered from to

Vaughan

Clay	0	75
Sand	75	85
Clay	85	105
Sand	105	125
Sand streaks	125	195
Yazoo Clay	195	275
Fine Sand	275	350
Sand streaks	350	375
Med Sand	375	400
Good sand	400	440

(mailing address)

WELL LOCATION:

sec. 1 T 11 N R. 1 E
1/2 miles N of Blacks Bay
(distance) (direction) (nearest town)

WELL PURPOSE:

(home, irrigation, municipal, industrial)

WELL COMPLETION DATA:

- (1) diameter (inches) 2
- (2) total depth (feet) 440
- (3) static water level (feet) 85 below above top of ground.
- (4) casing Steel 420
(material) (depth)
2 if telescope see back.
(size)
- (5) screen 20 420
(length) (depth to top)
7 SS
(size) (material)
- (6) pump 3 25
(HP) (yield gpm)
elec
(type power)
- (7) electric log No
(yes or no)
(organization running log)
- (8) how well bottom plugged Pin

DRILLERS REMARKS:

CODED


CODED

CODED

CODED

If well telescopes please sketch and show depths.

GROUND LEVEL

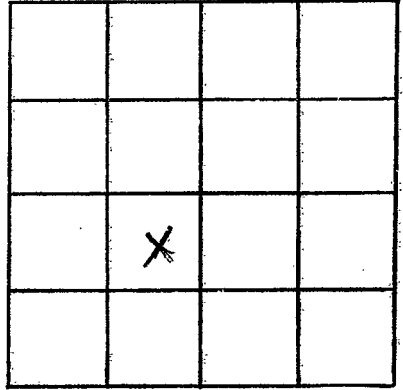

SECTION 1

Please indicate well location X.

ADDITIONAL INFORMATION

If more than one screen,
show locations of each on sketch.